IREDELL COUNTY HEALTH DEPARTMENT

STATESVILLE 704-878-5305 MOORESVILLE 704-664-5281

IMPROVEMENT PERMIT / AUTHORIZATION TO CONSTRUCT / OPERATION PERMIT / EXISTING SYSTEM INSPECTION

PERMIT# 88268 PIN# 4786 73 3583 DATE 3-28-00

OWNER OR CONTRACTOR James Sherrill PHONE: Business Home 878 0697

ADDRESS 148 Three Linda Ln Statesville

LOCATION 64E 3/4 mile Past Swann Rd on left.

SUBDIVISION BLOCK / SECTION LOT LOT AREA 8.43 acres SITE CLASS PS DESIGN FLOW 360 L.T.A.R. .33

Septic Tank: 1000 Gallons; STB 791 Date 11-28-00
Pump Tank: Gallons; PT Date
Pump Make: Model Serial No.
Nitrification Field: No Fields 1 Square Feet 1080 Linear Feet 360
No Lines 3 Trench Width 36" Max Trench Bottom Depth 36" Gravel Depth 12"

☑ New System ☐ Repair System Type: I. II. III. IV. V.
System Description: Conv. Trench
Repair System Description:
Maintenance Agreement Required: ☐ Yes ☑ No
☐ Slab ☐ Crawl Space ☑ Basement w/plumbing ☐ Basement wo/plumbing


☑ House/Mod. Home No. Bedrooms 3
☐ Mobile Home No. Bathrooms 2
☐ Business No. Employees
☐ Other

Water Supply: ☐ Individual ☑ Public ☐ Community


Comments/Conditions:

Comments/Conditions
1. INSTALLED WITH 4 TRENCHES
2. INSTALLED ASS HOWN
3. USED POLYLOK FILTER

INITIAL SITE SKETCH

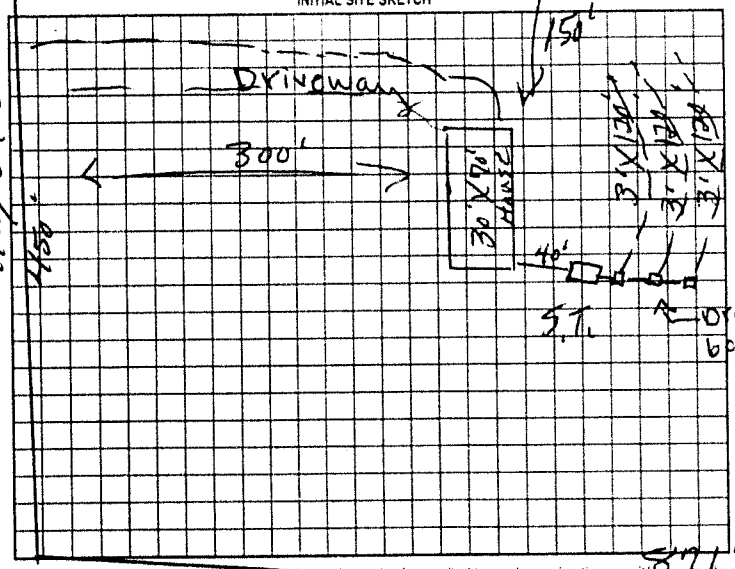

AS BUILT SKETCH

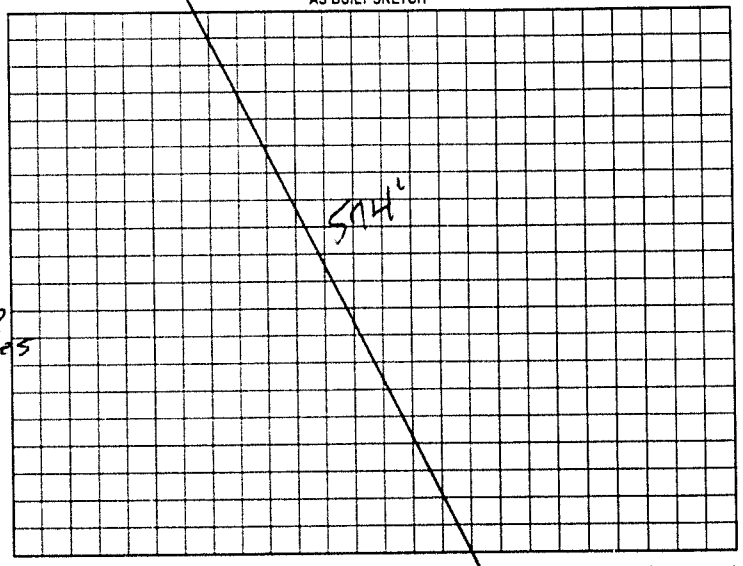

Permit can be suspended or revoked if any false information is supplied toward securing the permit/any unauthorized changes are made to the site/any unauthorized changes are made in the installation of the system. Improvement Permit with plat valid without expiration. Improvement Permit with site plan valid for sixty months. Authorization to Construct is valid for a period equal to that of Improvement Permit – not to exceed sixty months.

Signed: James Sherrill date 3-28-00 Installed by: C WAYNE CREASMAN

Improvement Permit by: F.C. Moore date 3-28-00 Operation Permit by: Dave Cook REHS date 02-05-01

Authorization to Construct by: F.C. Moore date 3-28-00 Existing System Inspection by: date

HEALTH DEPT. COPY WHITE OWNER COPY (FINAL) YELLOW OWNER COPY (INITIAL) PINK