3:00

IREDELL COUNTY HEALTH DEPARTMENT

STATESVILLE 704-878-5305 MOORESVILLE 704-664-5281

IMPROVEMENT PERMIT / AUTHORIZATION TO CONSTRUCT / OPERATION PERMIT / EXISTING SYSTEM INSPECTION

PERMIT # 166054 PIN # 4786 33 2643 DATE May 12, 2011

OWNER or APPLICANT Steven Lea PHONE: Business applicant 704 902 0119 Home:

OWNER or APPLICANT ADDRESS 1706 Mocksville Hwy, Cleveland NC 27013

LOCATION / DIRECTIONS Hwy 64 East on Right 1/10-1/4 mile past E. Page-Hughes Road

SUBDIVISION BLOCK / SECTION LOT # LOT AREA 5.98 Ac DESIGN FLOW 360 gpd L.T.A.R. .3

Septic Tank 1000 Gallons: STB 1012 Date 10/07/11
Pump Tank Gallons: P T Date
Pump Make Model Serial #
Nitrification Field No Fields 1 No Lines 4 Linear Feet 400
Trench Width 36" Max. Trench Bottom Depth 36" Gravel Depth 12"


☑ New System ☐ Repair ☐ Expansion System Type I (II) III IV V VI
System Description: Gravity conventional
Repair System Description: Gravity conventional
Maintenance Agreement Required ☐ YES ☒ NO
☒ GRAVITY ☐ PRESSURE

☒ Residence No. Bedrooms 3
☐ Business No. Persons
☐ Other No. Employees
☐ Slab ☒ Crawl Space
☐ Basement w/plumbing ☐ Basement w/o plumbing

Water Supply: ☐ Private ☒ Public ☐ Community


Comments / Conditions
N
PL
NTS

INITIAL SITE SKETCH

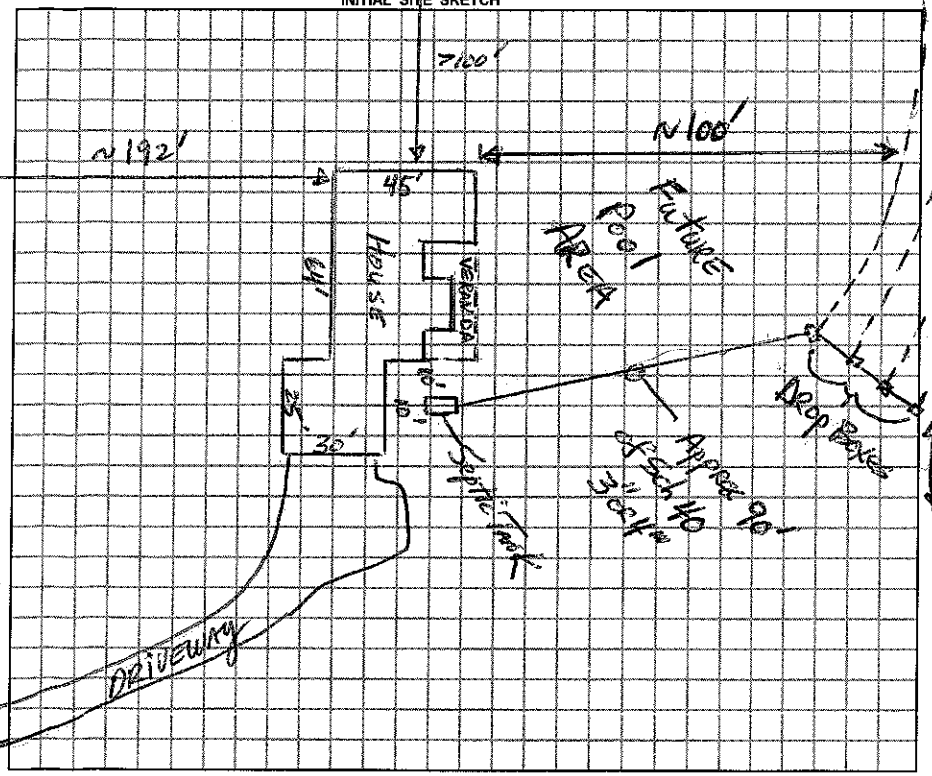

Comments / Conditions PolyLok Filter
PL
47' Sewer Line
>50' Installed 3 x 100' Chambers

AS BUILT SKETCH

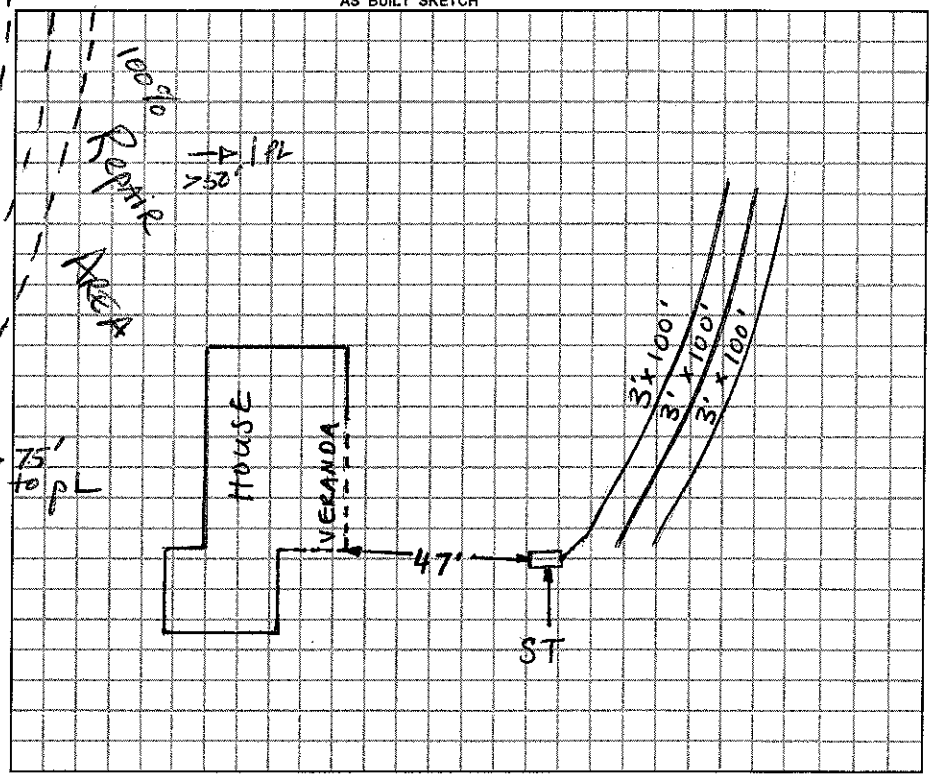

Permit can be suspended or revoked if any false information is supplied toward securing the permit / any unauthorized changes are made to the site / any unauthorized changes are made in the installation of the system.

☐ *IMPROVEMENT PERMIT w / plat valid without expiration.* ☒ *IMPROVEMENT PERMIT w / site plan valid for 60 mos.* ☐ *AUTHORIZATION TO CONSTRUCT valid for period equal to IMPROVEMENT PERMIT-not to exceed 60 mo.*

Owner / Applicant Signature: Dale Sloan Date 6-22-11
Improvement Permit by: D Hartman, REHS Date 5-12-11
Authorzation to Construct by: D Hartman, REHS Date 5-12-11
YOU SHOULD CONTACT A LOCATOR SERVICE PRIOR TO ANY EXCAVATION.

Installed by: Young Gas & Septic Inc
Operation Permit by: Wesley Mecimore, REHS #1377 Date: 4-3-12
Existing System Inspected by: Date:

WHITE COPY Environmental Health YELLOW COPY (Final) Owner / Applicant PINK COPY (Initial) Owner / Applicant