# IREDELL COUNTY HEALTH DEPARTMENT

STATESVILLE 704-878-5305 MOORESVILLE 704-664-5281

## IMPROVEMENT PERMIT / AUTHORIZATION TO CONSTRUCT / OPERATION PERMIT / EXISTING SYSTEM INSPECTION

PERMIT# 107323 PIN# 4786-33-9401 DATE 07-09-02

OWNER OR CONTRACTOR Billy Martin PHONE: Business 704-902-1115 Home

ADDRESS EAST PAGE HAGER RD STATESVILLE, NC 28625

LOCATION 64 EAST, @ EAST PAGE HAGER, 1/8 mile on Left.

SUBDIVISION BLOCK / SECTION LOT LOT AREA 9.662 AC SITE CLASS. PS DESIGN FLOW 480 L.T.A.R. .3

Septic Tank: 1000 Gallons; STB 1017 Date 9-27-05
Pump Tank: Gallons; PT Date
Pump Make: Model Serial No.
Nitrification Field: No Fields 1 Square Feet 1600' Linear Feet 533'
No Lines 4x133' Trench Width 36" Max Trench Bottom Depth 36" Gravel Depth 12"

☒ New System ☐ Repair System Type: I. II. III. IV. V. VI
System Description: CONV GRAV
Repair System Description: CONV GRAV
Maintenance Agreement Required: ☐ Yes ☒ No


☒ House/Mod. Home No. Bedrooms 4
☐ Mobile Home No. Bathrooms 3
☐ Business No. Employees
☐ Other
☐ Slab ☐ Crawl Space ☒ Basement w/plumbing ☐ Basement wo/plumbing

Water Supply: ☐ Individual ☒ Public ☐ Community

Comments/Conditions: ① MAINTAIN SETBACKS & INSTALL LINES ON CONTOURS ② CALL PRIOR TO INSTALLATION FOR FLAGOUT


Comments/Conditions: INSTALLED AS DRAWN

INITIAL SITE SKETCH

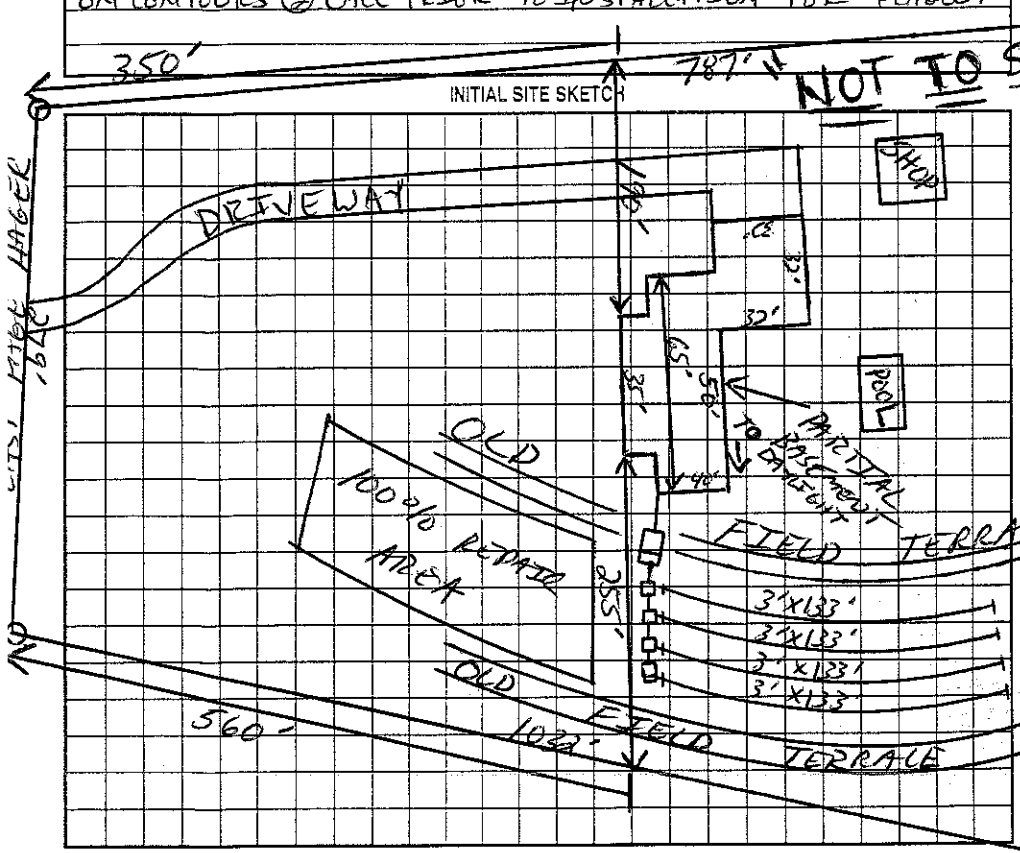


AS BUILT SKETCH

AN ACCEPTED SYSTEM WAS USED/INSTALLED 4X100' LINES OF QUICK 4 CHAMBERS

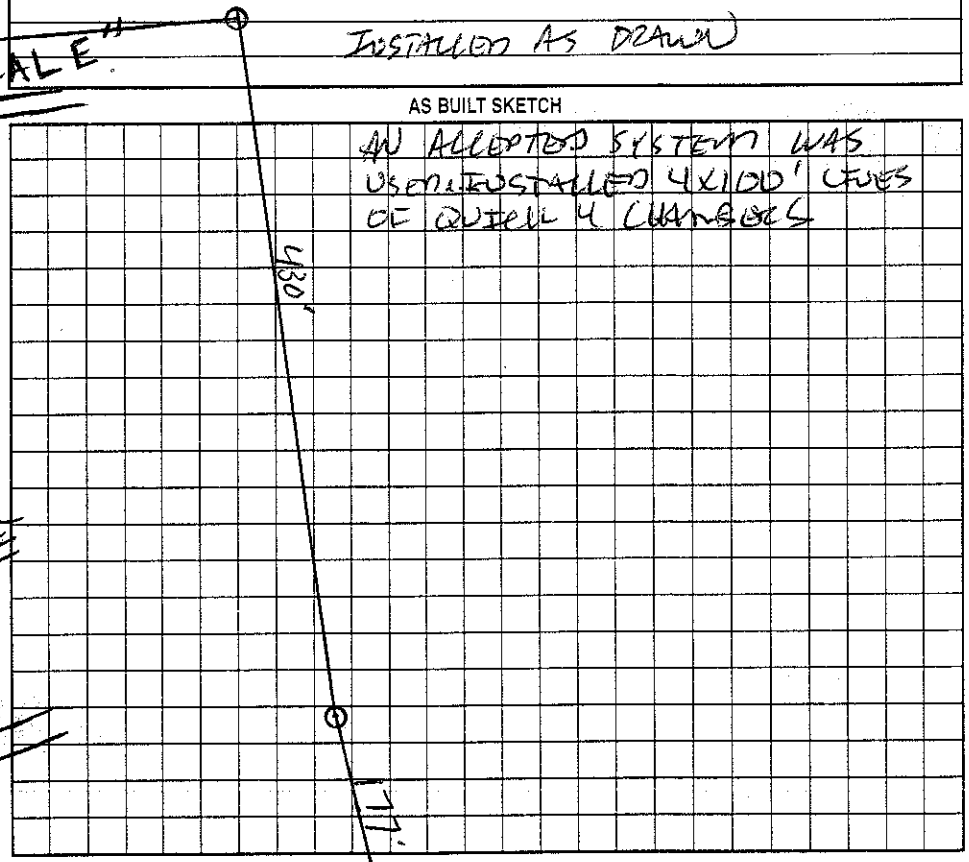


Permit can be suspended or revoked if any false information is supplied toward securing the permit/any unauthorized changes are made to the site/any unauthorized changes are made in the installation of the system. Improvement Permit with plat valid without expiration. Improvement Permit with site plan valid for sixty months. Authorization to Construct is valid for a period equal to that of Improvement Permit – not to exceed sixty months.

Signed: date 7-10-02

Improvement Permit by: date 07-09-02

Authorization to Construct by: date 07-09-02

Installed by: DAVID YUNTZ

Operation Permit by: date 11-17-05

Existing System Inspection by: date

HEALTH DEPT. COPY: WHITE OWNER COPY (FINAL): YELLOW OWNER COPY (INITIAL): PINK