IREDELL COUNTY HEALTH DEPARTMENT

Statesville Phone TR 3-7271 Mooresville Phone NO 3-1271

PERMIT TO INSTALL SEPTIC TANK

Permit NO. _____ Permit Date April 25 1964

Owner J. T. Steele Boat Home Address Hwy 64 E.

Installed By C Hoke Address _____


Location of Property Across from Robertson Cotton gin before Cool Springs.

| Tank | | Capacity | | Length of Lines | | Fixtures | |
|---|---|---|---|---|---|---|---|
| Block | ( ) | 800 | ( ) | 150' | ( ) | No. of Baths | (2) |
| Precast | (✓) | 900 | ( ) | 175' | ( ) | Dishwasher | ( ) |
| | | 1000 | (✓) | 200' | ( ) | Garbage Grdr. | ( ) |
| | | 1100 | ( ) | 225' | (✓) | Auto-Washer | (✓) |
| | | 1200 | ( ) | 250' | ( ) | Other | _____ |
| | | Other | _____ | Other | _____ | | |

NOTIFY HEALTH DEPARTMENT AT LEAST EIGHT HOURS BEFORE TANK IS TO BE INSPECTED.

Final Inspection 4-25 1964 Approved (✓) Disapproved ( )

Remarks well 50 - 20' cast iron access

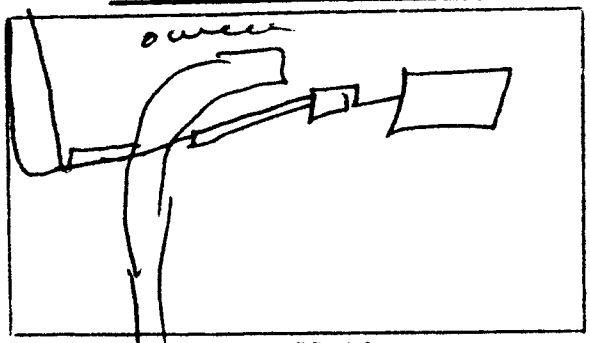


Sketch of Installation

Sanitarian