IREDELL COUNTY HEALTH DEPARTMENT - *ENVIRONMENTAL HEALTH* ☑ STATESVILLE OFFICE 704-878-5305 ☐ MOORESVILLE OFFICE 704-664-5281

IMPROVEMENT PERMIT / AUTHORIZATION TO CONSTRUCT / OPERATION PERMIT / EXISTING SYSTEM INSPECTION

PERMIT # 173008 PIN # 4786647907 DATE 6-18-12

OWNER Patti Cline APPLICANT: Same PHONE: Home/Cell # 704-872-8020 Business # N/A

SITE ADDRESS 186 Page Farm Rd. OWNER / APPLICANT ADDRESS 186 Page Farm Rd. Cleveland NC 27013

SITE DIRECTIONS Mocksville Hwy to Page Farm Rd.

SUBDIVISION N/A BLOCK / SECTION N/A LOT # N/A LOT AREA 10 acres DESIGN FLOW 120 gpd L.T.A.R. 0.25

Septic Tank 1000 Gallons: STB 760 Date 2-1-12

Pump Tank ____ Gallons: P T ____ Date ____

Pump Make ____ Model ____ Serial # ____

No. Nitrification Fields: 1 No. Lines 1 Linear Feet 133'

Trench Width 36" Max. Trench Bottom Depth 36" Gravel Depth 12"

☑ New System ☐ Repair ☐ Expansion System Type I (II) III IV V VI

System Description: Conventional - gravity

Repair System Description: Conventional - gravity

Maintenance Agreement Required ☐ YES ☑ NO

☑ GRAVITY ☐ PRESSURE

☐ Residence No. Bedrooms

☐ Business No. Persons 4

☑ Other Barn 25 seat restaurant No. Employees


☐ Slab ☐ Crawl Space

☐ Basement w/plumbing ☐ Basement w/o plumbing


Water Supply: ☑ Private ☐ Public ☐ Community

Comments / Conditions: Install conventional system on contour. An accepted system may also be installed

INITIAL SITE SKETCH

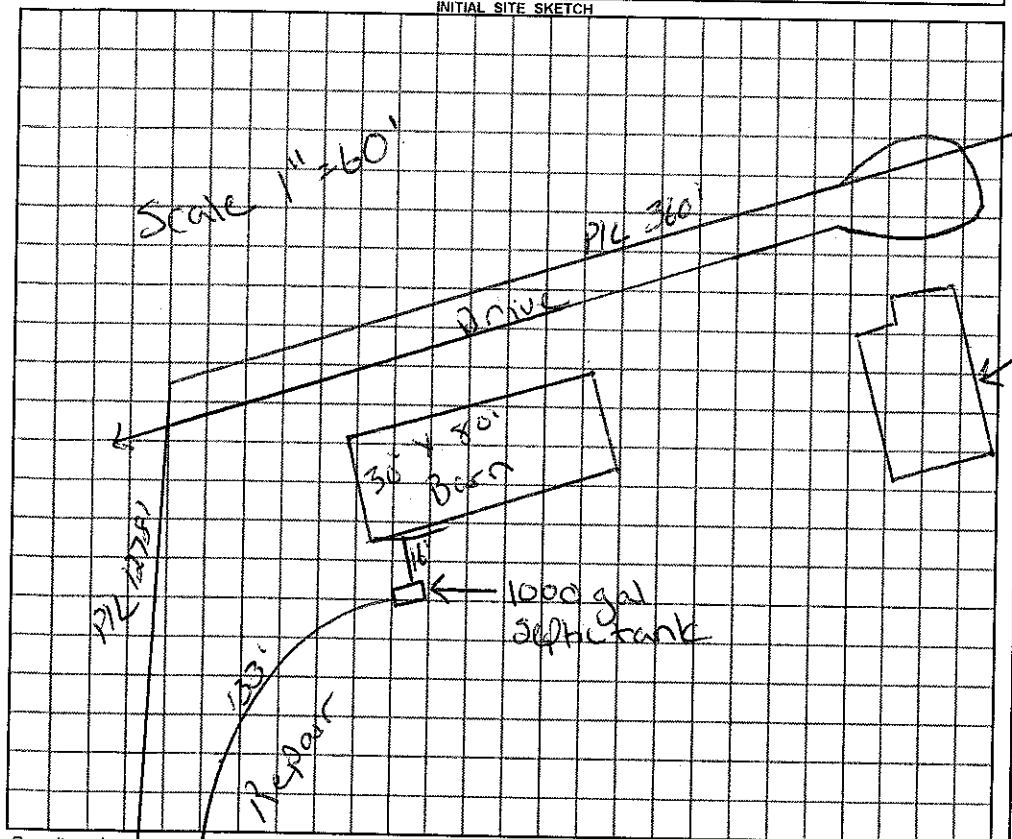

AS BUILT SKETCH

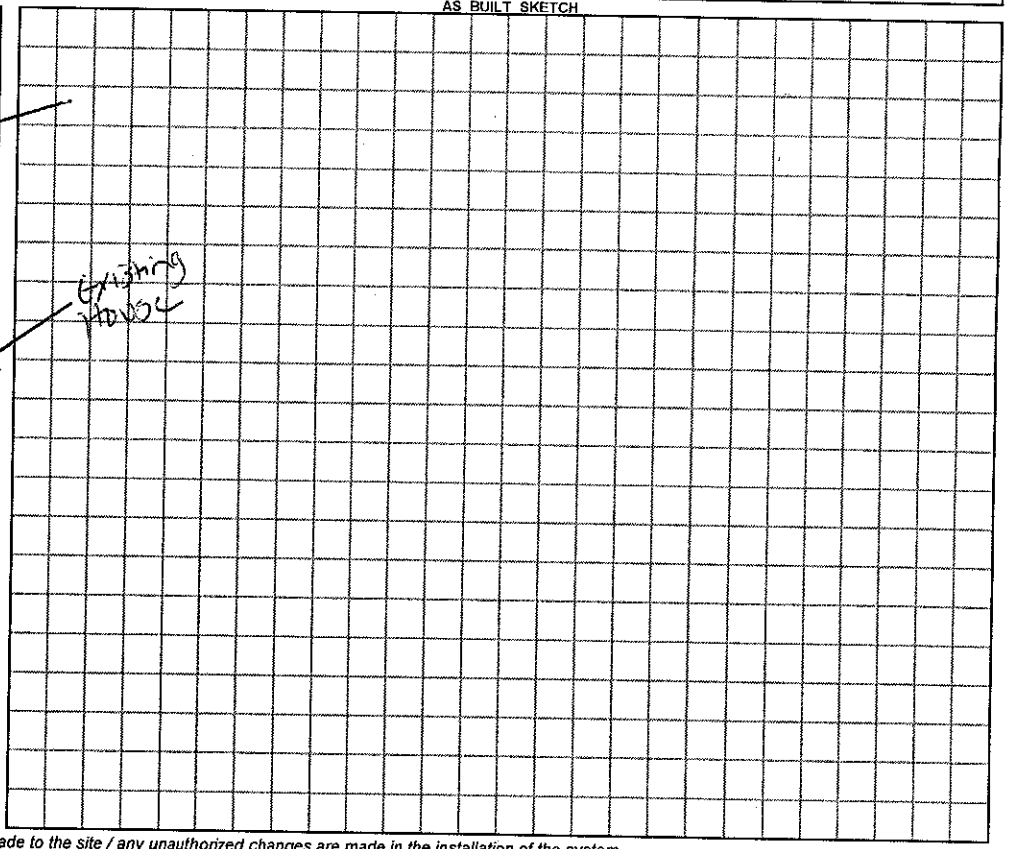

Permit can be suspended or revoked if any false information is supplied toward securing the permit / any unauthorized changes are made to the site / any unauthorized changes are made in the installation of the system.

☐ ***IMPROVEMENT PERMIT*** with plat valid without expiration. ☑ ***IMPROVEMENT PERMIT*** with plat ~~valid without expiration~~ site plan valid 60 mo. ☑ ***AUTHORIZATION TO CONSTRUCT*** valid for period equal to IMPROVEMENT PERMIT--not to exceed 60 mo.

Owner / Applicant Signature: Patti Cline Date 6-18-12 Installed by: Abee Grading

IMPROVEMENT PERMIT by: Justin Henderson REHS Date 6-18-12 OPERATION PERMIT by: ____ REHS Date 6-27-12

AUTHORIZATION TO CONSTRUCT by: Justin Henderson REHS Date 6-18-12 Existing System Inspected by: ____ REHS Date ____

YOU SHOULD CONTACT A LOCATOR SERVICE PRIOR TO ANY EXCAVATION

White Copy – Environmental Health YELLOW COPY (Final) Owner / Applicant PINK COPY (Initial) Owner / Applicant