ICHD - ENVIRONMENTAL HEALTH DIVISION

Statesville Offi[illegible]8-5305 Mooresville Office (704) 660-3625 PERMIT # AP 2022-2488

SEPTIC: IMPROVEMENT PERMIT / AUTHORIZATION TO CONSTRUCT / OPERATION PERMIT / EXISTING SYSTEM

PIN # 4786 -- 66 -- 4391

APPLICANT/OWNER: Jeanie Lentz APPLICANT ADDRESS: 463 Lentz Rd Statesville 28625

SITE ADDRESS: 1914 Mocksville Hwy Cleveland 27013 PHONE: (980) 829-7547 ALT. PHONE


SITE DIRECTIONS: N Center St, (L) Stockton St, (L) US-64 E SAP CONTROLLED: YES NO

SUBDIVISION: - SECTION: - LOT # - LOT AREA: 3 Ac DESIGN FLOW: Ext L.T.A.R.: Ext

Septic Tank 1000 (gal)	STB 760	Date 1-10-23	☐ New System ☑ Repair ☐ Expansion	System Type: I II III IV V VI	☑ Residence	No. Bedrooms 3	Water Supply
Pump Tank (gal)	PT	Date	System Description: Tank Replacement		☐ Business	No. Persons 6	☒ Private
Pump Make	Model	Serial #	Repair System Description:		☐ Other	No. Employees	☐ Public
# Nitrification Fields Ext	# Lines Ext	Linear Ft Ext	Maintenance Agreement Required: ☐ YES ☑ NO		☐ Slab	☐ Crawl Space	☐ Community
Trench Width Ext	Trench Bottom Depth(Low side) Ext	Gravel Depth -	☑ GRAVITY ☐ PRESSURE		☑ Basement w/ plumbing	☐ Basement w/o plumbing	


Comments / Conditions: Pump, crush, fill old tank. Existing system was 55ft from well upon inspection.

INITIAL SITE SKETCH

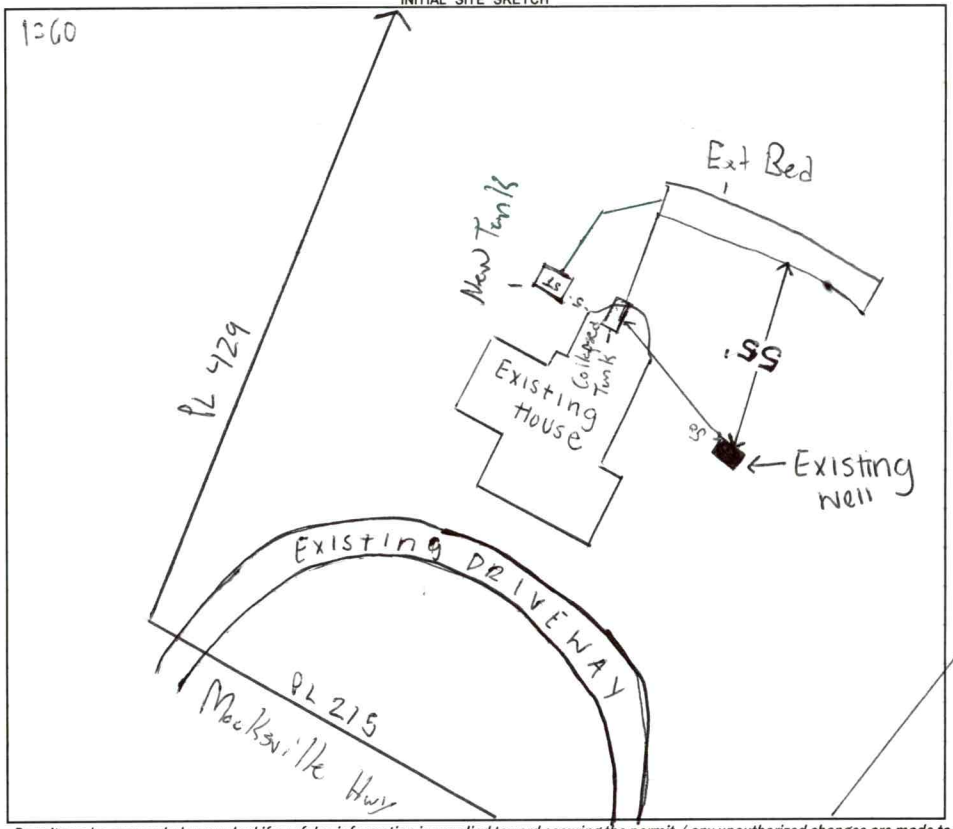

AS BUILT SKETCH

FOR SEPTIC FINAL INSPECTION CALL: 704-664-3703 between 8am-9am the day the inspection is needed. Be sure to speak with an inspector to confirm your time.

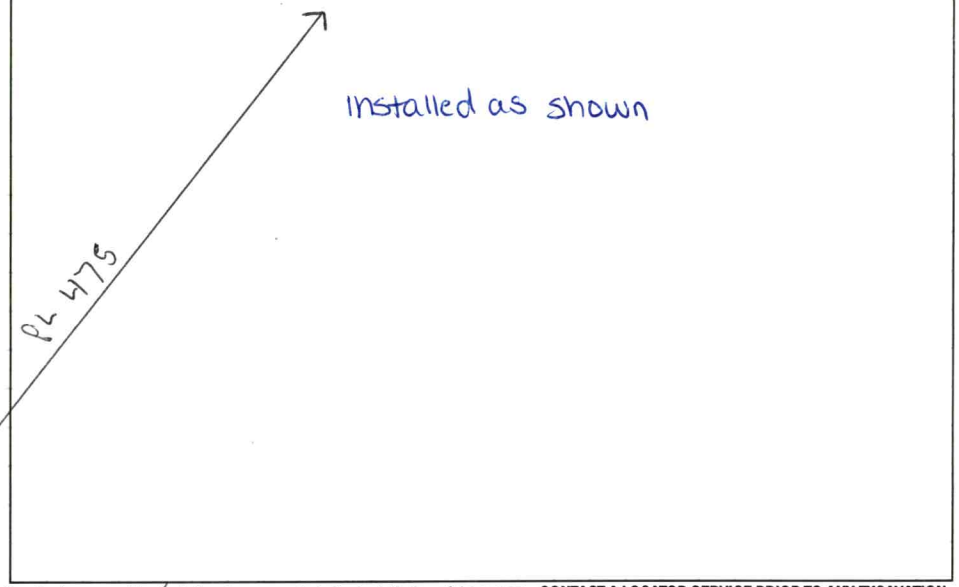

Permit can be suspended or revoked if any false information is supplied toward securing the permit / any unauthorized changes are made to the site / any unauthorized changes are made in the installation of the system. **CONTACT A LOCATOR SERVICE PRIOR TO ANY EXCAVATION**

☐ **IMPROVEMENT PERMIT** ***with plat*** *valid without expiration.* ☑ **IMPROVEMENT PERMIT** ***with site plan*** *valid for 60 mos.* ☑ **AUTHORIZATION TO CONSTRUCT** *valid for period equal to IMPROVEMENT PERMIT--not to exceed 60 mo.*

Owner / Applicant Signature: Online Signature Date: Installed by: Myers Septic

IMPROVEMENT PERMIT by: [signature] Date: 10/7/22 OPERATION PERMIT by: Sarah Bracken Date: 03/7/23

AUTHORIZATION TO CONSTRUCT by: [signature] Date: 10/7/22 Existing System Inspected by: Date:

FOR SEPTIC FINAL INSPECTION: CALL 704-664-3703 between 8am-9am the day the inspection is needed.

Item	Date	Initials
Drain Lines Checked		
Tanks Checked		
Pressure Manifold or Valve Box Checked		
Pressure Head Set		
Electrical Checked		
Floats Set		
Alarm Checked		
Maintenance Contract Needed? Y / N		
Comments:		

Repairs Only	
	State Code
Failing System Code	
Type of Distribution	G or P
Type of Failure/Malfunction	
Primary Cause of Failure/Malfunction	
Age of System? _____	
Initial or Repair? _____	



Tax Map Information

• PIN	4786664391.000
• Address	1914 MOCKSVILLE HWY
• Account #	Acct 80064263
• Tax Owner	GIDDENS JASMINE E
• Mailing Address	1914 MOCKSVILLE HWY
•	CLEVELAND, NC 27013
• GIS Owner	GIDDENS JASMINE E
• Deed Info	2632 / 1944 - WD - 20190722
• Tax Acres	3 AC
• Lot #	
• Description	PURDY US64
• Zoning	R20
• Old Parcel #	1211G00000B026
• Bldg Value	$52,210
• OBXF Value	$5,880
• Land Value	$43,260
• Total Value	$101,350
• Defer Value	$0
• Tax Districts	-ALLCOUNTY FIRE- -

IREDELL COUNTY NC

MAP FOR REFERENCE ONLY
NOT A LEGAL DOCUMENT

Iredell County, North Carolina makes no claims and no warranties, expressed or implied, concerning the validity or accuracy of the GIS data presented on this map.

Print map scale is approximate. Critical layout or measurement activities should not be done using this resource.