IREDELL COUNTY HEALTH DEPARTMENT - *ENVIRONMENTAL HEALTH* ☒ STATESVILLE OFFICE 704-878-5305 ☐ MOORESVILLE OFFICE 704-664-5281

IMPROVEMENT PERMIT / AUTHORIZATION TO CONSTRUCT / OPERATION PERMIT / EXISTING SYSTEM INSPECTION

PERMIT # 168939 PIN # 4786-76-0306 DATE 2 November 2011

OWNER Eddie Walker APPLICANT: Clayton Homes PHONE: Home/Cell # (704) 239-3693 Business #

SITE ADDRESS 1946 Mocksville Hwy OWNER / APPLICANT ADDRESS

SITE DIRECTIONS Hwy 64 E on Rt. Across From Cool Springs School

SUBDIVISION BLOCK / SECTION LOT # LOT AREA ±0.88Ac. DESIGN FLOW 360 gpd L.T.A.R. 0.3 / 477 gpd

Septic Tank 1000 gal Gallons: STB Date

Pump Tank Gallons: P T Date

Pump Make Model Serial #

No. Nitrification Fields: 1 No. Lines 5 Linear Feet 300

Trench Width 36" Max. Trench Bottom Depth 36" Gravel Depth N/A

☑ New System ☐ Repair ☐ Expansion System Type I II ⓘ IV V VI

System Description: 25% Reduction System.

Repair System Description: 25% Reduction System.

Maintenance Agreement Required ☐ YES ☑ NO

☑ GRAVITY ☐ PRESSURE

☑ Residence No. Bedrooms 3

☐ Business No. Persons

☐ Other No. Employees

☐ Slab ☑ Crawl Space


☐ Basement w/plumbing ☐ Basement w/o plumbing

Water Supply: ☐ Private ☑ Public ☐ Community

Comments / Conditions

"Tuff-Filter" Filter

INITIAL SITE SKETCH

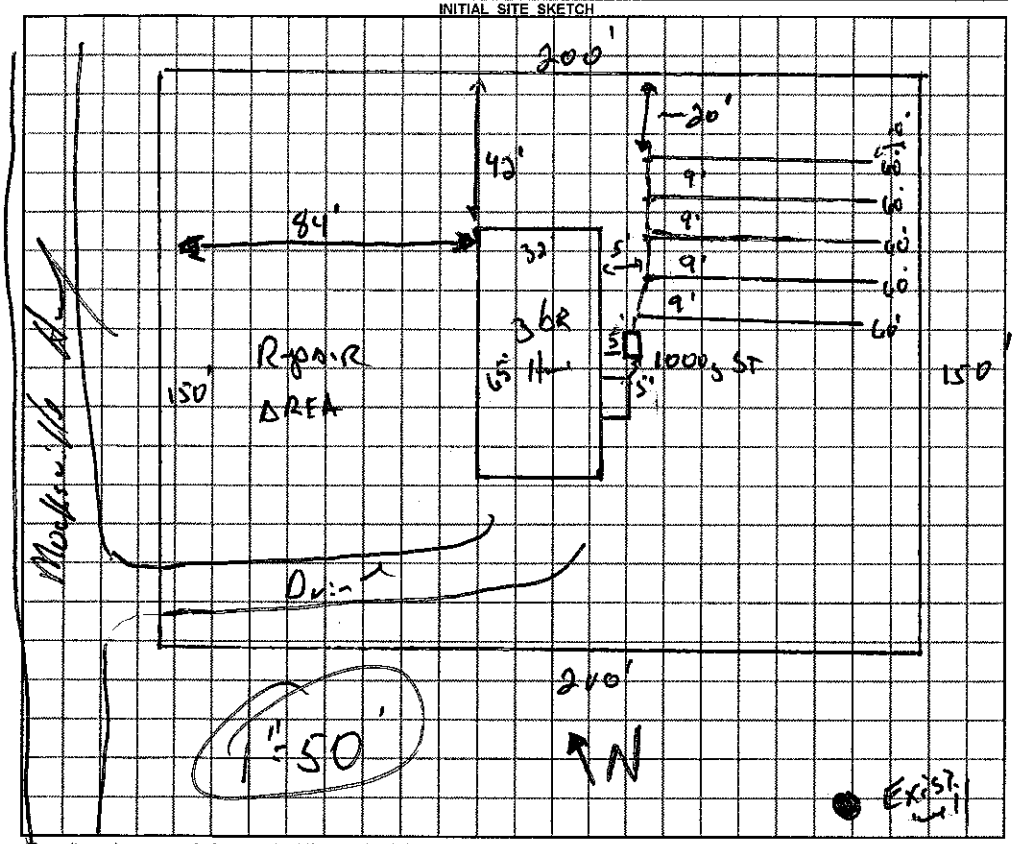

AS BUILT SKETCH

Installed as Drawn

Permit can be suspended or revoked if any false information is supplied toward securing the permit / any unauthorized changes are made to the site / any unauthorized changes are made in the installation of the system.

☐ ***IMPROVEMENT PERMIT*** *with plat valid without expiration.* ☑ ***IMPROVEMENT PERMIT*** *with plat valid without expiration. site plan valid 60 mo.* ☑ ***AUTHORIZATION TO CONSTRUCT*** valid for period equal to IMPROVEMENT PERMIT--not to exceed 60 mo.

Owner / Applicant Signature: Date 11/2/11 Installed by: Tim Abee

IMPROVEMENT PERMIT by: REHS Date 2 Nov. 11 OPERATION PERMIT by: REHS Date 22 Nov. 11

AUTHORIZATION TO CONSTRUCT by: REHS Date 2 Nov. 11 Existing System Inspected by: REHS Date

YOU SHOULD CONTACT A LOCATOR SERVICE PRIOR TO ANY EXCAVATION

White Copy -- Environmental Health YELLOW COPY (Final) Owner / Applicant PINK COPY (Initial) Owner / Applicant