IREDELL COUNTY HEALTH DEPARTMENT

STATESVILLE 704-878-5305 MOORESVILLE 704-664-5281

IMPROVEMENT PERMIT / AUTHORIZATION TO CONSTRUCT / OPERATION PERMIT / EXISTING SYSTEM INSPECTION

PERMIT# REPAIR PIN# 4786-88-0735 DATE 6-7-07

OWNER OR APPLICANT ROBIN W. MILLER PHONE: Business 704-902-6869 Home 704-872-8991

ADDRESS 2048 MOCKSVILLE HIGHWAY CLEVELAND NC 27013

LOCATION US 64 EAST HOUSE ON RIGHT AT WOODLEAF ROAD AT BOX #2048

SUBDIVISION _____ BLOCK / SECTION _____ LOT _____ LOT AREA 2.12 ACRES SITE CLASS. PS DESIGN FLOW 360 L.T.A.R. 0.30 GPD/FT²

Septic Tank: 1000 Gallons; STB _____ Date 6-2007

Pump Tank: _____ Gallons; PT _____ Date _____

Pump Make: _____ Model _____ Serial No. _____

Nitrification Field: No. Fields 1 Square Feet EQP 1200 Linear Feet 300

No. Lines FOUR Trench Width 36" Max Trench Bottom Depth 36" Gravel Depth N/A

☒ ~~New System~~ ☒ Repair ☐ Expansion System Type: I (II) III IV V VI

System Description: _____

Repair System Description: 25% REDUCTION, GRAVITY

Maintenance Agreement Required: ☐ Yes ☒ No

☒ House/Mod. Home No. Bedrooms 3

☐ Mobile Home No. Persons _____

☐ Business No. Employees _____

☐ Other _____


Water Supply: ☐ Individual ☒ Public ☐ Community

☒ Gravity ☐ Pressure ☐ Slab ☒ Crawl Space ☐ Basement w/plumbing ☐ Basement wo/plumbing


Comments/Conditions: ① INSTALL NEW SEPTIC TANK AT LOCATION SHOWN, CRUSH & FILL EXISTING SEPTIC TANK ② INSTALL NEW 25% REDUCTION SYSTEM ON CONTOUR AS SHOWN

Comments/Conditions: Yellow & Pink - to Septic Tank Installer

INITIAL SITE SKETCH

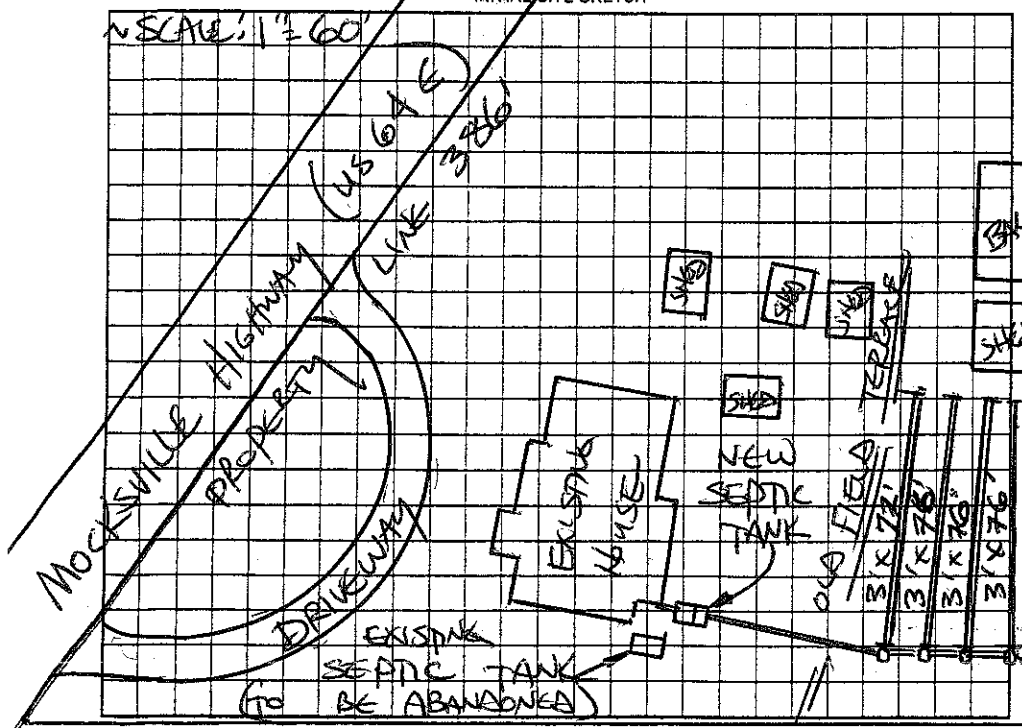

AS BUILT SKETCH

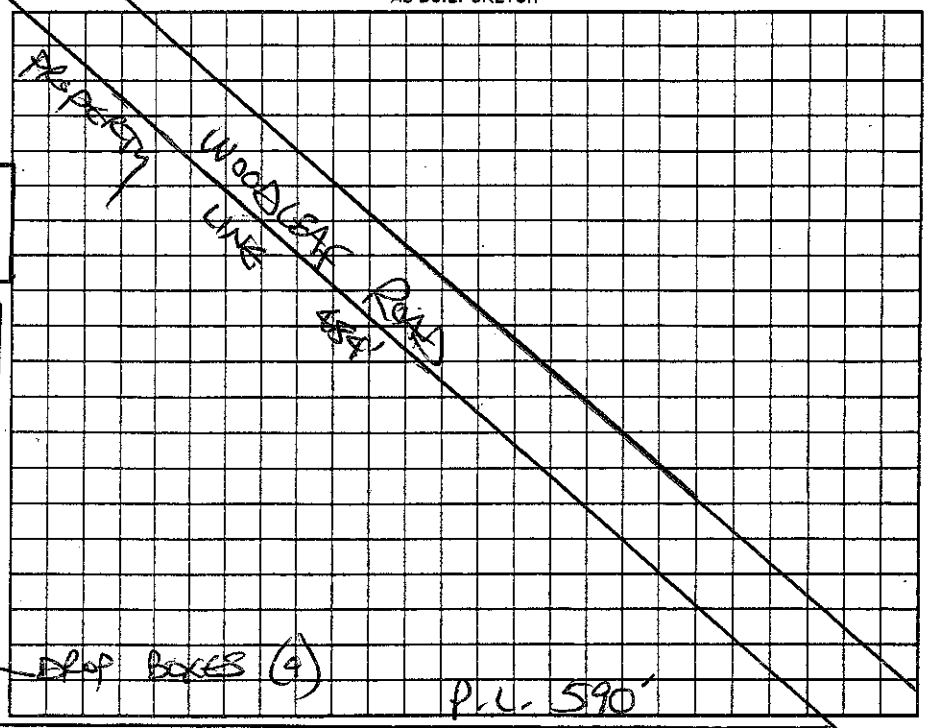

Permit can be suspended or revoked if any false information is supplied toward securing the permit/any unauthorized changes are made to the site/any unauthorized changes are made in the installation of the system. Improvement Permit with plat valid without expiration ☐ Improvement Permit with site plan valid for sixty months ☒ Authorization to Construct is valid for a period equal to that of Improvement Permit – not to exceed sixty months.

Signed: Robin W Miller date 6-7-07 Installed by: Tommy Gregg

Improvement Permit by: STEVE HEDRICK date 6-7-07 Operation Permit by: _____ date 6-21-07

Authorization to Construct by: STEVE HEDRICK date 6-7-07 Existing System Inspection by: _____ date _____

HEALTH DEPT. COPY: WHITE OWNER COPY (FINAL): YELLOW OWNER COPY (INITIAL): PINK