IREDELL COUNTY HEALTH DEPARTMENT - *ENVIRONMENTAL HEALTH* ☑ STATESVILLE OFFICE 704-878-5305 ☐ MOORESVILLE OFFICE 704-664-5281

IMPROVEMENT PERMIT / AUTHORIZATION TO CONSTRUCT / OPERATION PERMIT / EXISTING SYSTEM INSPECTION

PERMIT # 169133 PIN # 4787-13-3021 DATE 17 November 2011

OWNER Jeff Minor APPLICANT: Clayton Homes PHONE: Home/Cell # (704) 239-3693 Business #

SITE ADDRESS 549 Cool Springs Rd. Stat. OWNER / APPLICANT ADDRESS

SITE DIRECTIONS Old Mocksville Rd. Turn onto Cool Springs Rd. First Drive on Rt. past Ledge Hill Rd.

SUBDIVISION BLOCK / SECTION LOT # LOT AREA 1.01 Ac. DESIGN FLOW 360 g/d L.T.A.R. 0.3 g/ft²d

Septic Tank Exist. Gallons: STB Date
Pump Tank Gallons: P T Date
Pump Make Model Serial #
No. Nitrification Fields: 1 No. Lines 1 Linear Feet 100'
Trench Width 36" Max. Trench Bottom Depth 36" Gravel Depth N/A


☐ New System ☐ Repair ☑ Expansion System Type I II III IV V VI
System Description: 25% Reduction System.
Repair System Description: 50% Reduction System.
Maintenance Agreement Required ☐ YES ☑ NO
☑ GRAVITY ☐ PRESSURE

☑ Residence No. Bedrooms 3
☐ Business No. Persons
☐ Other No. Employees
☐ Slab ☑ Crawl Space
☐ Basement w/plumbing ☐ Basement w/o plumbing

Water Supply: ☑ Private ☐ Public ☐ Community

Comments / Conditions: Follow contour / Keep away from Fill Area /

INITIAL SITE SKETCH

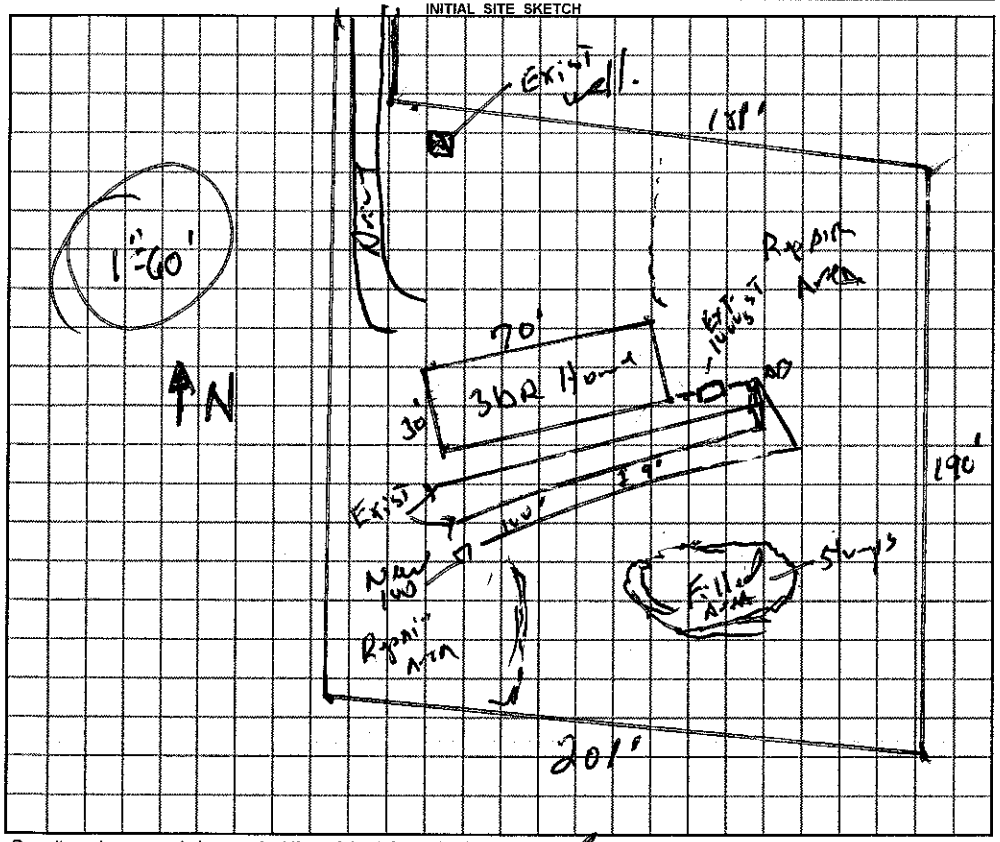

AS BUILT SKETCH

Installed as Drawn

Permit can be suspended or revoked if any false information is supplied toward securing the permit / any unauthorized changes are made to the site / any unauthorized changes are made in the installation of the system.

☐ *IMPROVEMENT PERMIT* with plat valid without expiration. ☑ *IMPROVEMENT PERMIT* with plat valid 60 mo. Site plan valid 60 mo. ☑ *AUTHORIZATION TO CONSTRUCT* valid for period equal to IMPROVEMENT PERMIT–not to exceed 60 mo.

Owner / Applicant Signature: Debra Abee Date 12/9/11

IMPROVEMENT PERMIT by: REHS Date 17 Nov 11

AUTHORIZATION TO CONSTRUCT by: REHS Date 17 Nov 11

YOU SHOULD CONTACT A LOCATOR SERVICE PRIOR TO ANY EXCAVATION

Installed by: Tim Abee

OPERATION PERMIT by: REHS Date 3 Feb. 2012

Existing System Inspected by: REHS Date

White Copy – Environmental Health YELLOW COPY (Final) Owner / Applicant PINK COPY (Initial) Owner / Applicant