IREDELL COUNTY HEALTH DEPARTMENT

STATESVILLE 704-878-5305 (CI) MOORESVILLE 704-664-5281

IMPROVEMENT PERMIT / AUTHORIZATION TO CONSTRUCT / OPERATION PERMIT / EXISTING SYSTEM INSPECTION

PERMIT# (B) 143894 PIN# ~~478-7055-673~~ 140057 DATE 13 Sept 07

OWNER OR APPLICANT Larry & Cindy Jones PHONE: Business ______ Home 518-786-0910

ADDRESS 12 Arnold Ave Latham NY 12110

LOCATION Old Mocksville Road (R) White Oak on left at intersection of White Oak and Cool Spring

SUBDIVISION ______ BLOCK / SECTION ______ LOT 1 LOT AREA 50 AC SITE CLASS. PS DESIGN FLOW 360 L.T.A.R. .25

Septic Tank: 1500 Gallons; STB 7011 Date 12-13-00 | ☒ New System ☐ Repair ☐ Expansion System Type: I II (III) IV V VI | ☒ House/Mod. Home No. Bedrooms 3 | Water Supply:

Pump Tank: ______ Gallons; PT ______ Date ______ | System Description: 25% Gravity | ☐ Mobile Home No. Persons ______ | ☐ Individual

Pump Make: ______ Model ______ Serial No. ______ | Repair System Description: 25% Gravity | ☐ Business No. Employees ______ | ☒ Public ☐ Community

Nitrification Field: No Fields ______ Square Feet 1480 Linear Feet 360 | Maintenance Agreement Required: ☐ Yes ☐ No | ☒ Other Building/Shop

No Lines 4 Trench Width 36" Max Trench Bottom Depth 36 Gravel Depth NA ☒ Gravity ☐ Pressure ☐ Slab ☒ Crawl Space ☐ Basement w/plumbing ☐ Basement wo/plumbing

Comments/Conditions:


Comments/Conditions: * Rake side walls

* Supply line will need clean outs according to code


Maintain all setbacks

Install on contour

INITIAL SITE SKETCH

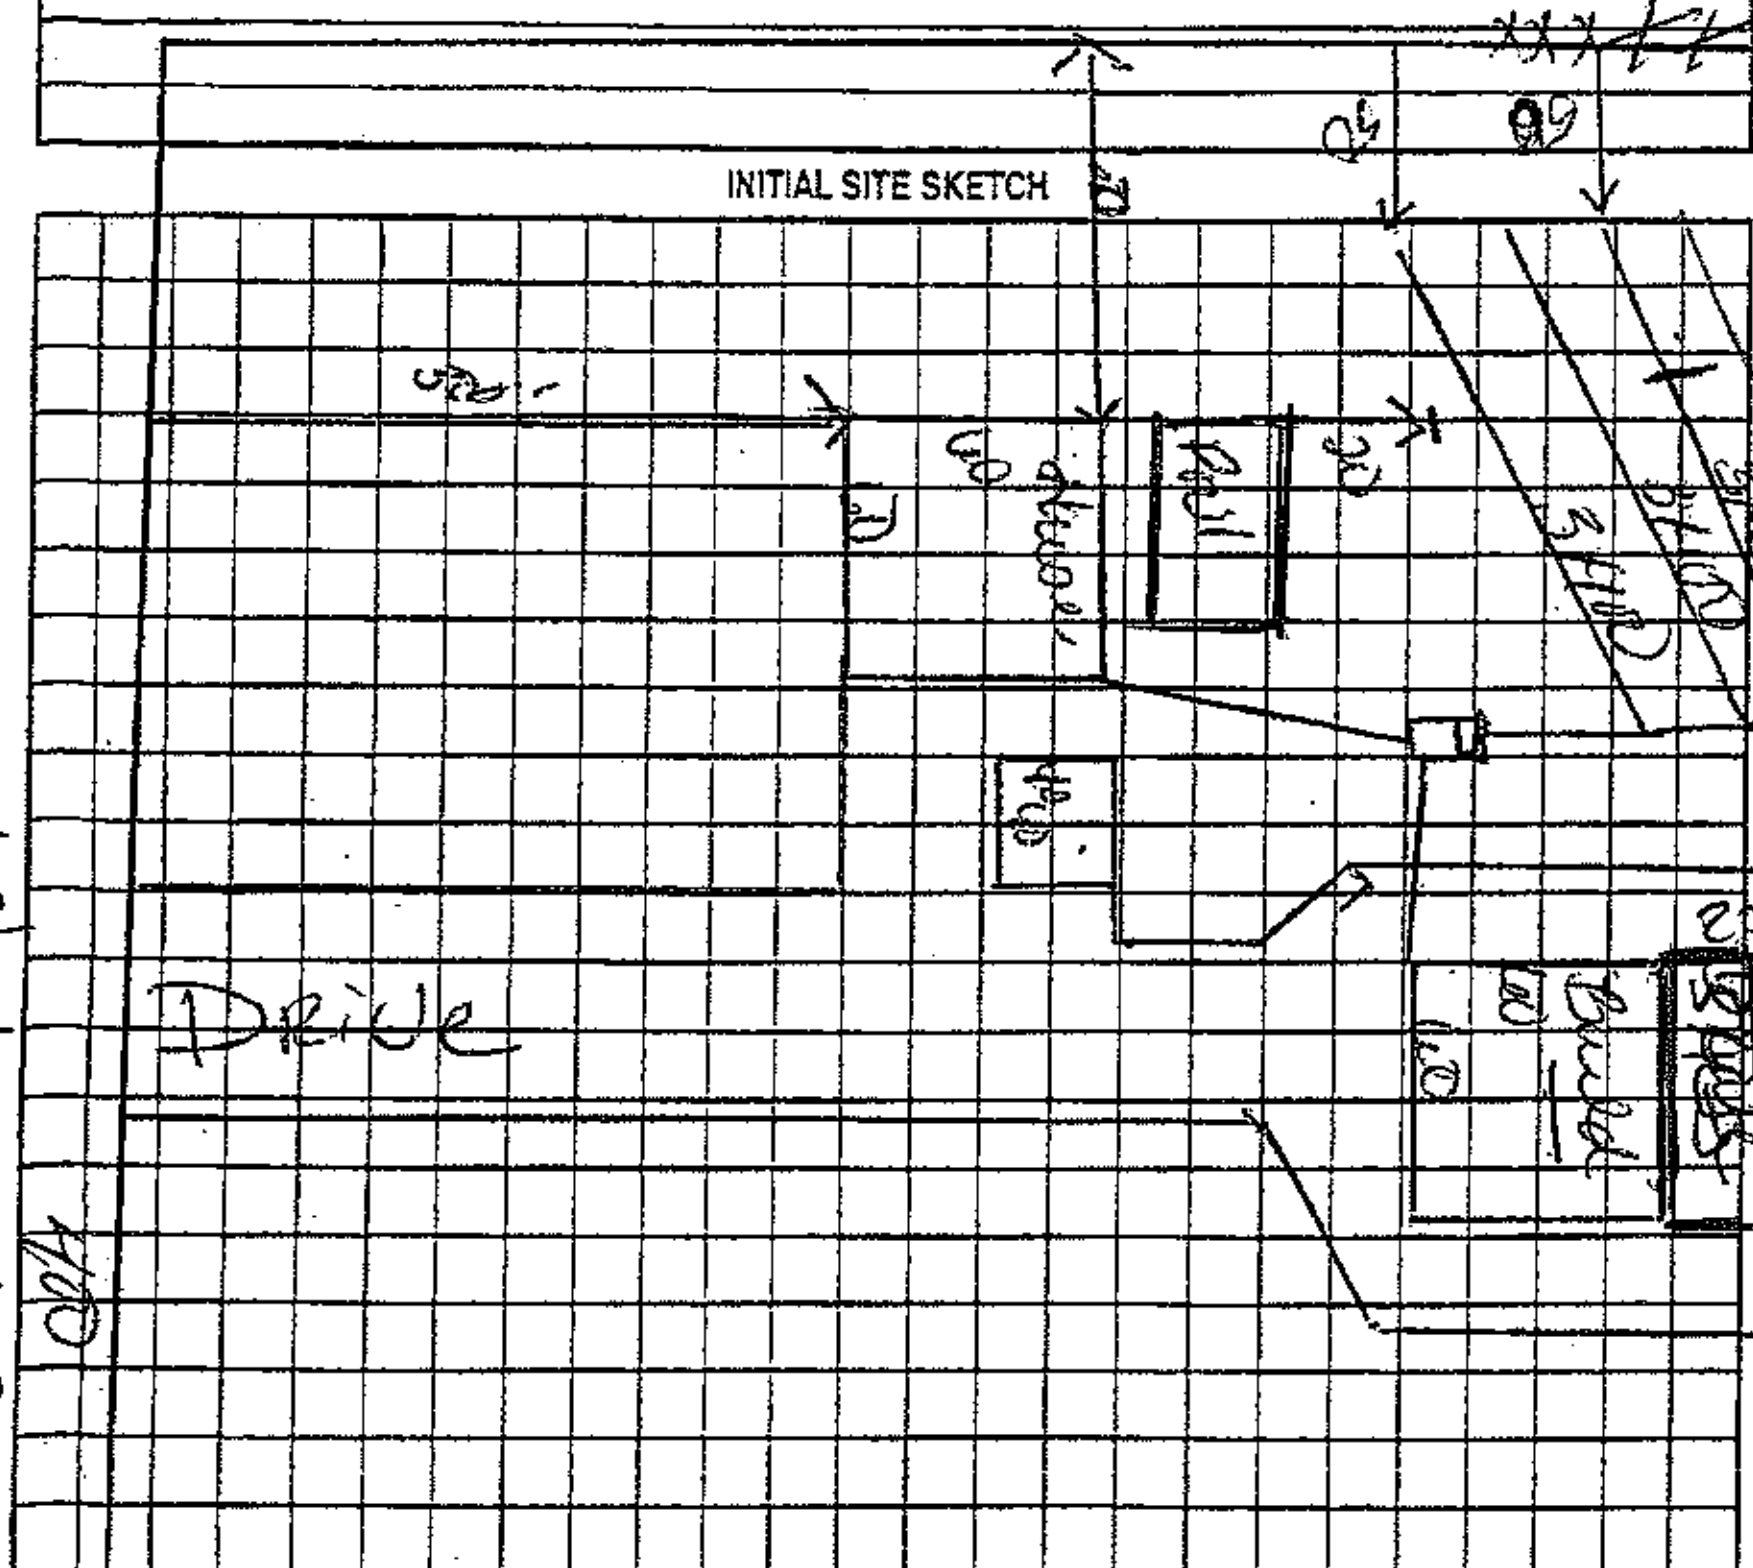

AS BUILT SKETCH

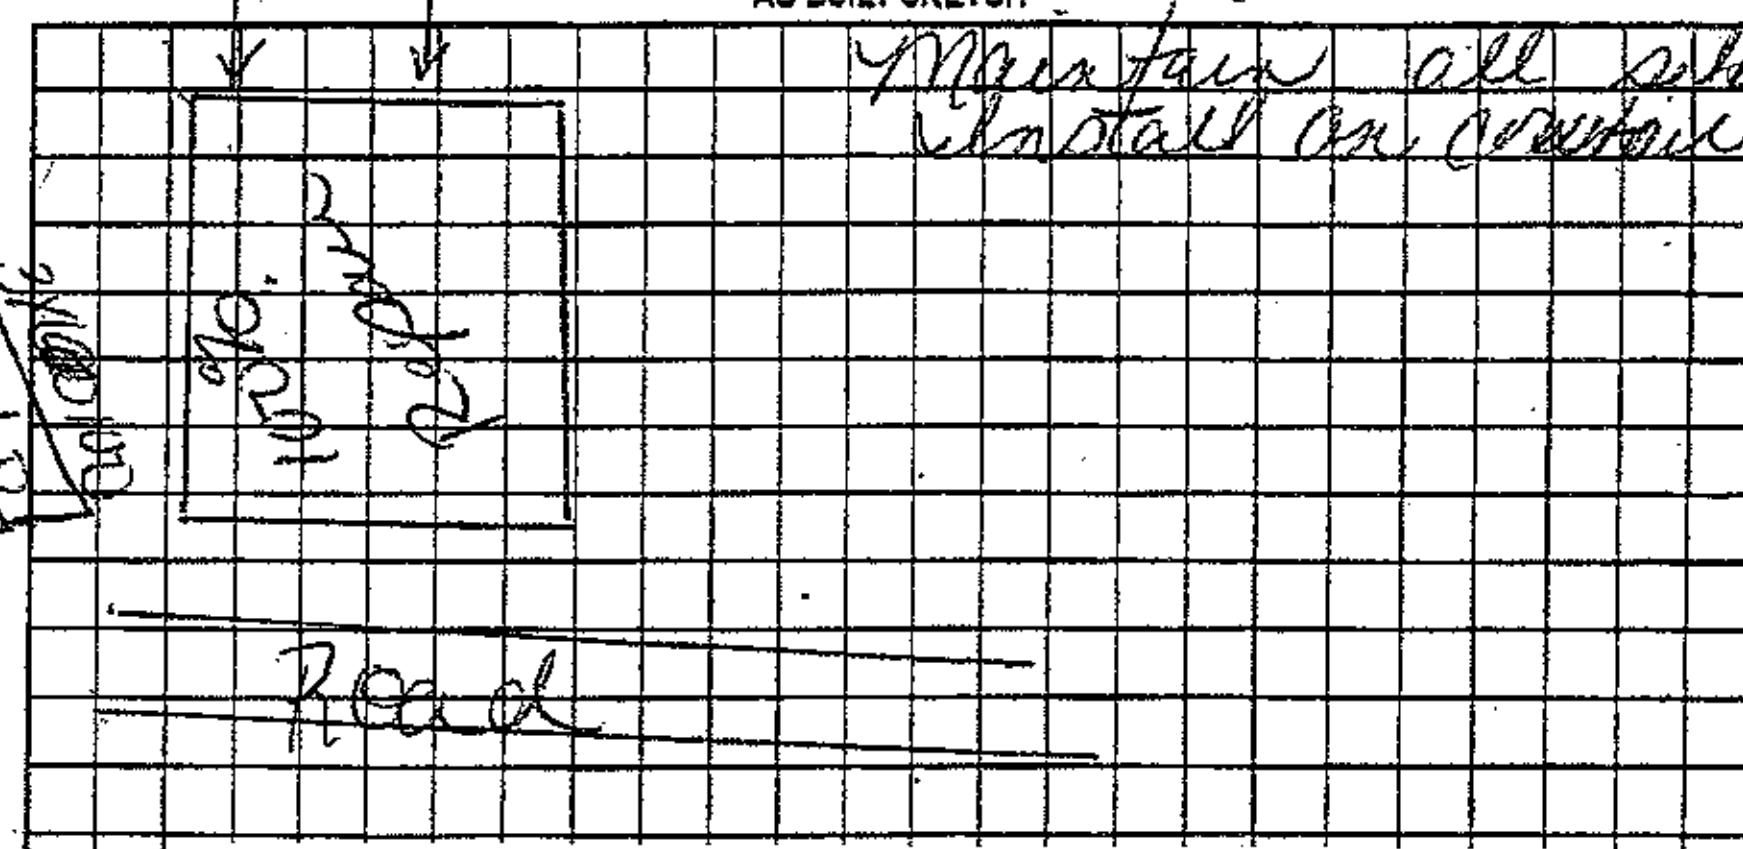

Location of the proposed BUILDING ADDITION **addition does not appear to impact the existing on-site septic system.**NOTE:**

R. STEVE HEDRICK **REHS**

Date: JANUARY 10, 2010

ICHD-Environmental Health Division

White Oak Branch Rd

Permit can be suspended or revoked if any false information is supplied toward securing the permit/any unauthorized changes are made to the site/any unauthorized changes are made in the installation of the system. Improvement Permit with plat valid without expiration ☐ Improvement Permit with site plan valid for sixty months ☒ Authorization to Construct is valid for a period equal to that of Improvement Permit – not to exceed sixty months.

Signed: [signature] date ______ Installed by: L&S Grading

Improvement Permit by: [signature] date 13 Sept 07 Operation Permit by: [signature] date 9-24-07

Authorization to Construct by: [signature] date 13 Sept 07 Existing System Inspection by: ______ date ______

HEALTH DEPT. COPY: WHITE OWNER COPY (FINAL): YELLOW OWNER COPY (INITIAL): PINK