IREDELL COUNTY HEALTH DEPARTMENT

STATESVILLE 704-878-5305 (21) MOORESVILLE 704-664-5281

IMPROVEMENT PERMIT / AUTHORIZATION TO CONSTRUCT / OPERATION PERMIT / EXISTING SYSTEM INSPECTION

PERMIT# ~~116965~~ 116965 RIN# 4787-22-3950 DATE 12-8-03

OWNER OR CONTRACTOR JAMES ABRUZZO PHONE: Business _____ Home 704-873-2955

ADDRESS 119 ABRUZZO LANE STATESVILLE NC 28625

LOCATION OLD MOCKSVILLE RD NE, TR 'COOL SPRINGS' ROAD, TR ABRUZZO LANE, 2ND LOT ON RIGHT

SUBDIVISION ABRUZZO BLOCK / SECTION _____ LOT 1 LOT AREA 0.89 ACRE SITE CLASS. PS DESIGN FLOW 480 L.T.A.R. 0.30 GPD/FT²

Septic Tank: 1000 Gallons; STB 825 Date 10-20-03

Pump Tank: _____ Gallons; PT _____ Date _____

Pump Make: _____ Model _____ Serial No. _____

Nitrification Field: No Fields 1 Square Feet 1600 Linear Feet 540

No Lines FIVE Trench Width 36" Max Trench Bottom Depth 36" Gravel Depth 12"

☑ New System ☐ Repair System Type: I, II, III, IV, V, VI

System Description: CONVENTIONAL, GRAVITY

Repair System Description: 25% REDUCTION, GRAVITY

Maintenance Agreement Required: ☐ Yes ☑ No

☐ House/Mod. Home ☑ Mobile Home ☐ Business ☐ Other

No. Bedrooms 4 No. Bathrooms 2 No. Employees _____


☐ Slab ☑ Crawl Space ☐ Basement w/plumbing ☐ Basement wo/plumbing

Water Supply: ☐ Individual ☑ Public ☐ Community


Comments/Conditions: INSTALL LINES ON CONTOUR AS FLAGGED ON SITE.

Comments/Conditions: SYSTEM ALTERED AS SHOWN BELOW WITHOUT HEALTH DEPT. PRIOR APPROVAL USING TIRE CHIP AGGREGATE. 1-23-03 (OWEN LEVINER INSTALLER)

INITIAL SITE SKETCH

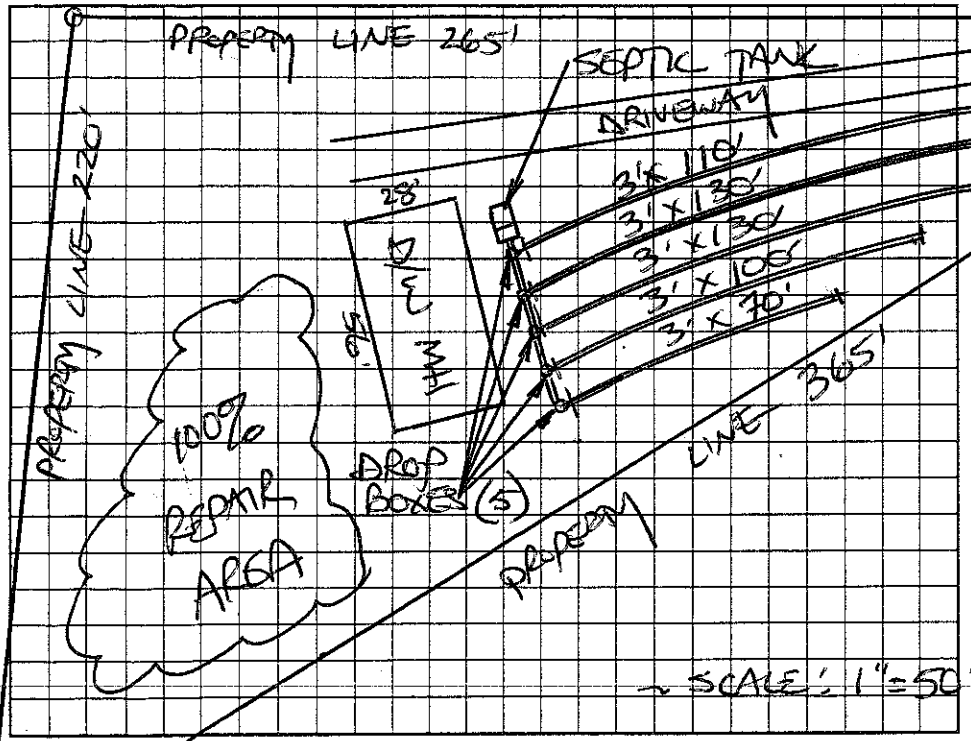

AS BUILT SKETCH

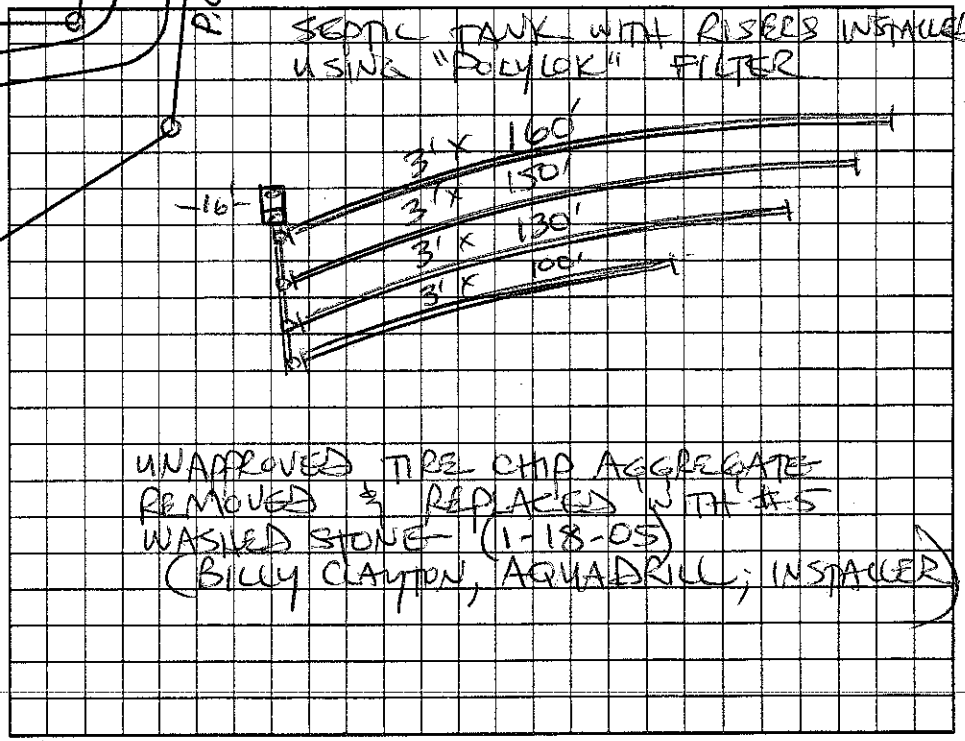

Permit can be suspended or revoked if any false information is supplied toward securing the permit/any unauthorized changes are made to the site/any unauthorized changes are made in the installation of the system. Improvement Permit with plat valid without expiration. Improvement Permit with site plan valid for sixty months. Authorization to Construct is valid for a period equal to that of Improvement Permit – not to exceed sixty months.

Signed: James M. Abruzzo date 12-8-03 Installed by: BILLY CLAYTON, AQUADRILL

Improvement Permit by: STEVE HEDRICK date 12-8-03 Operation Permit by: STEVE HEDRICK date 1-20-05

Authorization to Construct by: STEVE HEDRICK date 12-8-03 Existing System Inspection by: _____ date _____

HEALTH DEPT. COPY: WHITE OWNER COPY (FINAL): YELLOW OWNER COPY (INITIAL): PINK