IREDELL COUNTY HEALTH DEPARTMENT

STATESVILLE 704-878-5305 MOORESVILLE 704-664-5281

IMPROVEMENT PERMIT / AUTHORIZATION TO CONSTRUCT / OPERATION PERMIT / EXISTING SYSTEM INSPECTION

PERMIT# 145803 PIN# 4787236400 DATE 10-31-07

OWNER OR APPLICANT Clayton Homes PHONE: Business 704.873-2347 Home

ADDRESS 2026 Northside Drive Statesville NC 28677

LOCATION 42E 60 Cool Spring 42E Cool Spring

SUBDIVISION BLOCK / SECTION LOT LOT AREA 2.0 SITE CLASS. B DESIGN FLOW 360 L.T.A.R. 3

Septic Tank: 1000 Gallons; STB 760 Date 8-5-07

Pump Tank: Gallons; PT Date

Pump Make: Model Serial No.

Nitrification Field: No Fields Square Feet 900 Linear Feet 300

No Lines 3 Trench Width 36" Max Trench Bottom Depth 36

☑ New System ☐ Repair ☐ Expansion System Type: I II III IV V VI

System Description: 2570 Gravity

Repair System Description: 2570 pump

Maintenance Agreement Required: ☐ Yes ☐ No

Gravel Depth N/A ☐ Gravity ☐ Pressure

☑ House/Mod. Home ☐ Mobile Home ☐ Business ☐ Other

No. Bedrooms 3 No. Persons No. Employees

Water Supply: ☐ Individual ☑ Public ☐ Community

☐ Slab ☑ Crawl Space ☐ Basement w/plumbing ☐ Basement wo/plumbing


Comments:/Conditions:

Unstall on Contour
Maintain all setbacks


Comments:/Conditions:

Red Polylock Septic marker

INITIAL SITE SKETCH

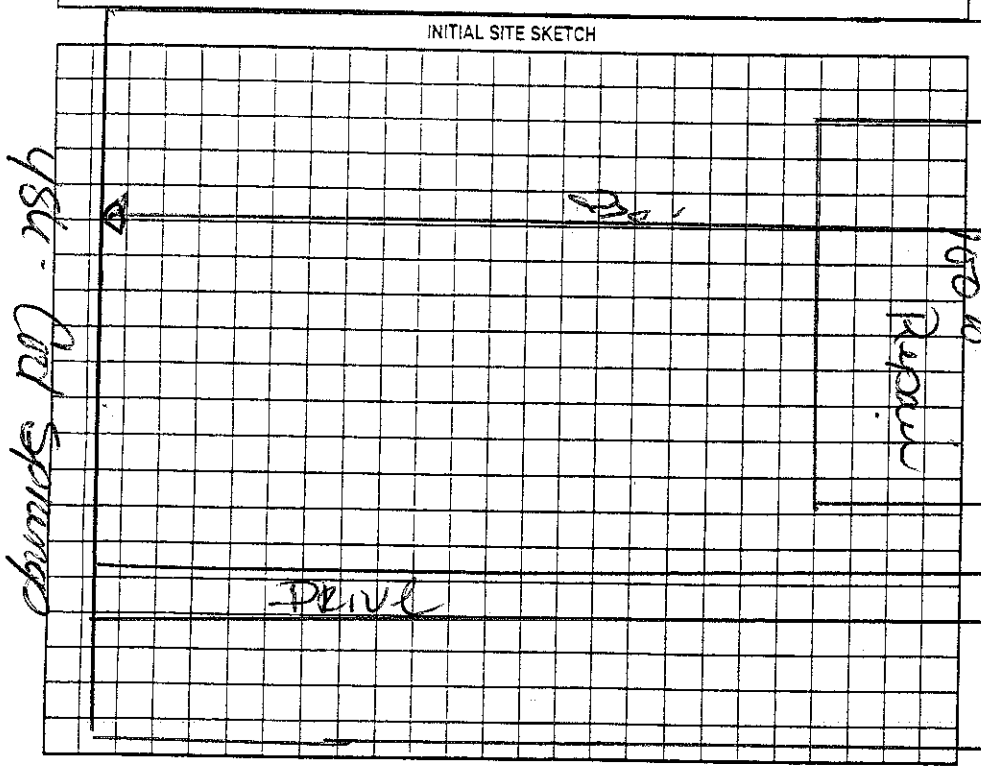

AS BUILT SKETCH

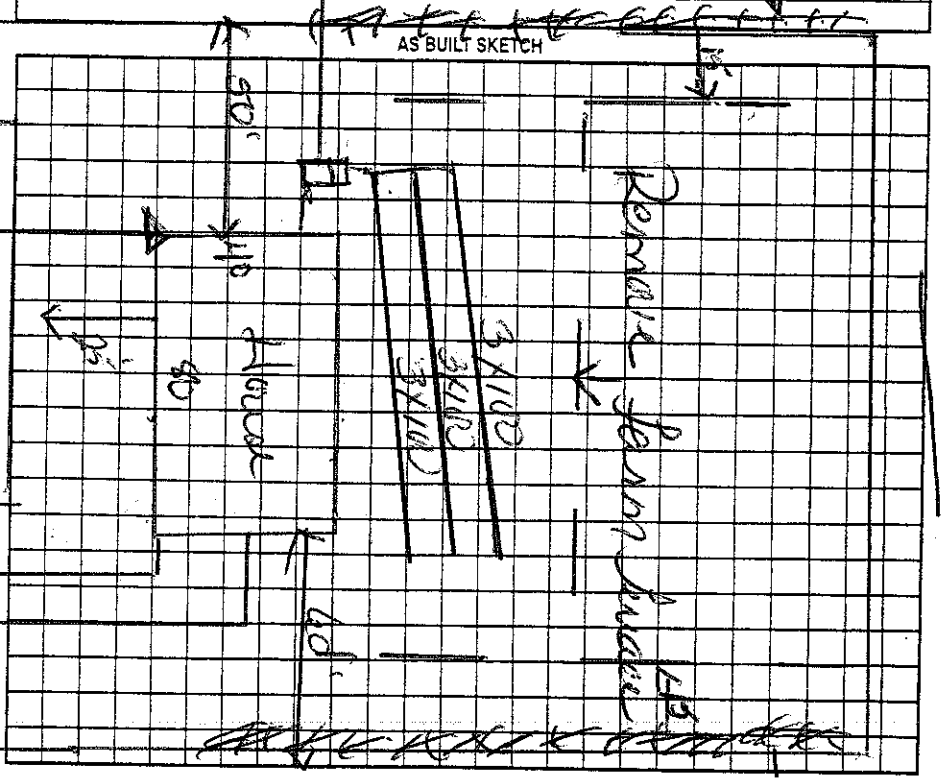

Permit can be suspended or revoked if any false information is supplied toward securing the permit/any unauthorized changes are made to the site/any unauthorized changes are made in the installation of the system. Improvement Permit with plat valid without expiration ☐ Improvement Permit with site plan valid for sixty months ☑ Authorization to Construct is valid for a period equal to that of Improvement Permit – not to exceed sixty months.

Signed: Deena Allen date 10-31-07 Installed by: Abel Grading

Improvement Permit by: Kelly Cook date 10-31-07 Operation Permit by: Kelly Cook date 11-16-2007

Authorization to Construct by: Kelly Cook date 10-31-07 Existing System Inspection by: date

HEALTH DEPT. COPY: WHITE OWNER COPY (FINAL): YELLOW OWNER COPY (INITIAL): PINK