IREDELL COUNTY HEALTH DEPARTMENT

Statesville Office (704) 878-5305 Mooresville Office (704) 660-3625 PERMIT # 209720

IMPROVEMENT PERMIT / AUTHORIZATION TO CONSTRUCT / OPERATION PERMIT / EXISTING SYSTEM

PIN # 4787337498

APPLICANT: Nancy West APPLICANT ADDRESS: 120 Hawks Rd.

SITE ADDRESS: 120 Hawks Rd. PHONE: 704-929-3817 ALT. PHONE: N/A

SITE DIRECTIONS: Hwy 21 N TR Church Late Rd TL Old Mocksville Rd TR Cool Springs Rd TL Hawks Rd.

SUBDIVISION: Nancy Gayle West SECTION: N/A LOT # 1 LOT AREA: 0.72 acres DESIGN FLOW: 360 gpd L.T.A.R.: 0.25

Septic Tank	1000 (gal)	STB	760	Date	12-5-14
Pump Tank	N/A (gal)	PT	N/A	Date	N/A
Pump Make	N/A	Model	Poly lok	Serial #	PL-68
# Nitrification Fields	1	# Lines	15	Linear Ft:	368
Trench Width	36"	Max. Trench Bottom Depth	36"	Gravel Depth	N/A

☐ New System ☑ Repair ☐ Expansion System Type: I II (III) IV V VI

System Description:

Repair System Description: 25% Reduction

Maintenance Agreement Required: ☐ YES ☑ NO

☑ GRAVITY ☐ PRESSURE

☑ Residence ☐ Business ☐ Other ☐ Slab ☐ Basement w/plumbing ☑ Basement w/o plumbing


No. Bedrooms 3 No. Persons 6 No. Employees ☐ Crawl Space

Water Supply: ☐ Private ☑ Public ☐ Community


Comments / Conditions: Pump & crush existing septic tank. Install new septic tank @ location shown below. Install a 25% Reduction System on contour with serial distribution.

- It is recommended that all maple trees be removed from septic area!!

INITIAL SITE SKETCH

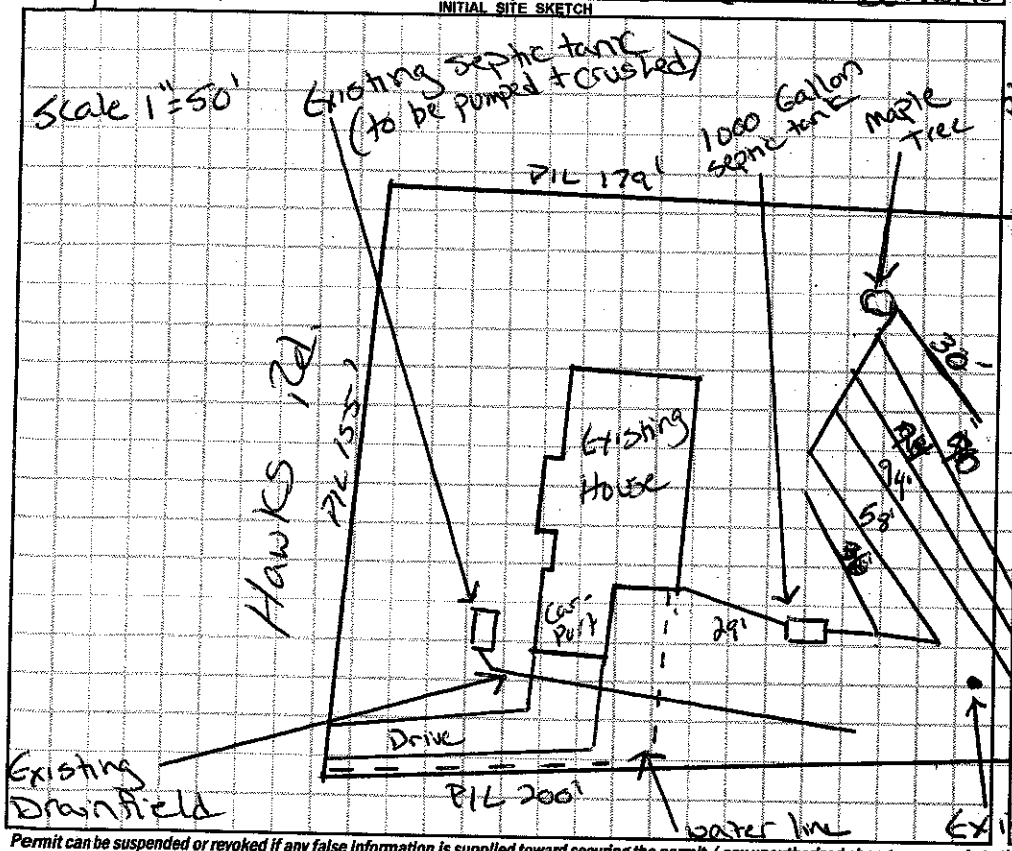

AS BUILT SKETCH

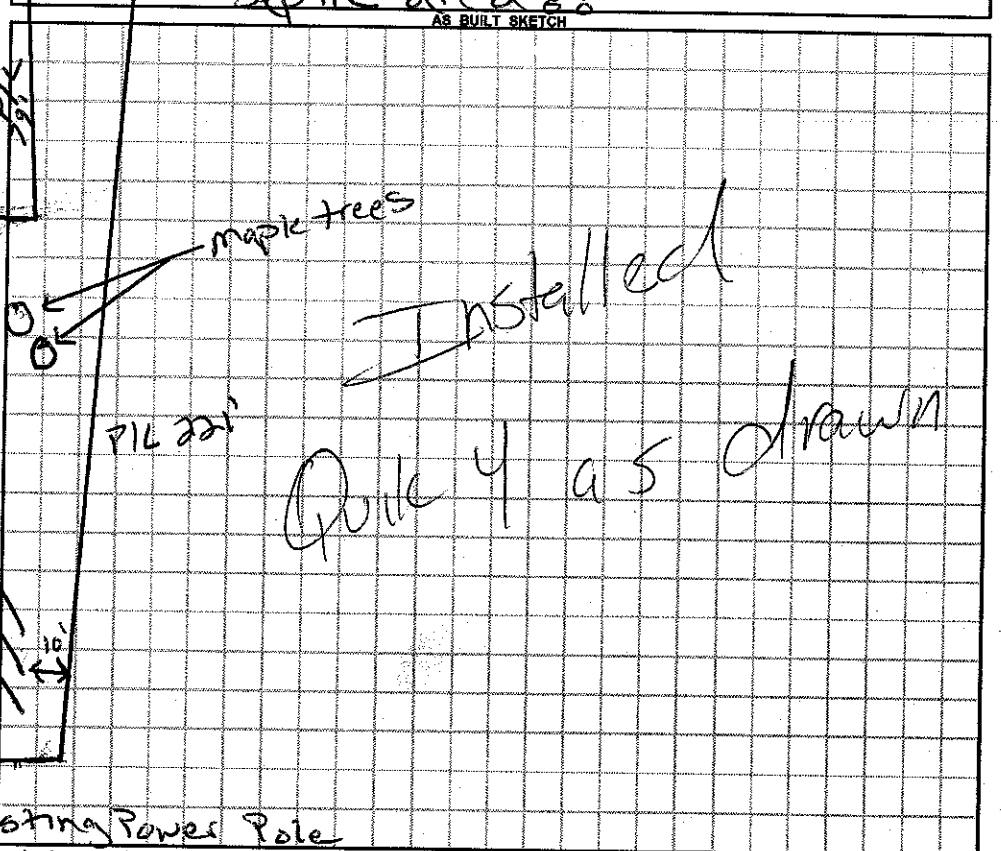

Permit can be suspended or revoked if any false information is supplied toward securing the permit / any unauthorized changes are made to the site / any unauthorized changes are made in the installation of the system. **CONTACT A LOCATOR SERVICE PRIOR TO ANY EXCAVATION**

☐ **IMPROVEMENT PERMIT** *with plat valid without expiration.* ☐ **IMPROVEMENT PERMIT** *with site plan valid for 60 mos.* ☐ **AUTHORIZATION TO CONSTRUCT** *valid for period equal to IMPROVEMENT PERMIT--not to exceed 60 mo.*

Owner / Applicant Signature: Nancy Gayle West Date: 4-17-15 Installed by: A-1 Backhoe

IMPROVEMENT PERMIT by: Justin Revelos Date: 4-17-15 OPERATION PERMIT by: Date: 04/23/15

AUTHORIZATION TO CONSTRUCT by: Justin Revelos Date: 4-17-15 Existing System Inspected by: Date:

Health Dept. Copy - WHITE Applicant (Final Approval) - YELLOW Applicant (Conditional Approval) - PINK