IREDELL COUNTY HEALTH DEPARTMENT

STATESVILLE 704-878-5305 MOORESVILLE 704-664-5281

IMPROVEMENT PERMIT / CERTIFICATE OF COMPLETION / OPERATION PERMIT / EXISTING SYSTEM INSPECTION

400

PROPERTY DESCRIPTION NO. 66697 DATE 5-29-97 TAX MAP NO. 4787-34-5730 pt. Watershed: ☐ Yes ☐ No

OWNER OR CONTRACTOR Larry J. Coover PHONE: Business _____ Home _____

ADDRESS 249 Country Woods Lane

LOCATION 64E TL Cool Spr Rd Cross I-77 TR Hawks Rd TL Bridge Bottom 1/8mi TL Private Dr.

SUBDIVISION _____ BLOCK / SECTION _____ LOT _____ LOT AREA 2.224 SITE CLASS. PS DESIGN FLOW 360 L.T.A.R. .33

Septic Tank: 1000 Gallons; STB 1012 Date 4-15-97

Pump Tank: _____ Gallons; PT _____ Date _____

Pump Make: _____ Model _____ Serial No. _____

Nitrification Field: ~~No Fields~~ 1 ~~Square Feet~~ 1050 ~~Linear Feet~~ 360

No Lines 3 Trench Width 36" Max Trench Bottom Depth 36" Gravel Depth 12"

☑ New System ☐ Repair System Type: ☐ I, II, III, IV, V, VI

System Description: Conv. Gravity

Repair System Description: " "

~~Maintenance Agreement Required:~~ ☐ ~~Yes~~ ☑ ~~No~~

☐ House/Mod. Home No. Bedrooms 3

☑ Mobile Home No. Bathrooms 2

☐ Business No. Employees _____

☐ Other _____


☐ Slab ☑ Crawl Space ☐ Basement w/plumbing ☐ Basement wo/plumbing

Water Supply: ☑ Individual ☐ Community ☐ Public


Comments: ← 340' →

Comments:

INITIAL SITE SKETCH

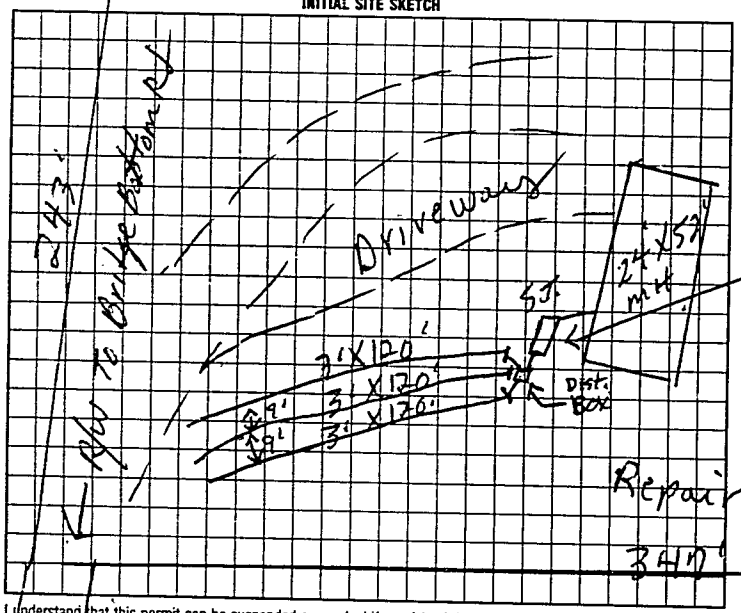

AS BUILT SKETCH

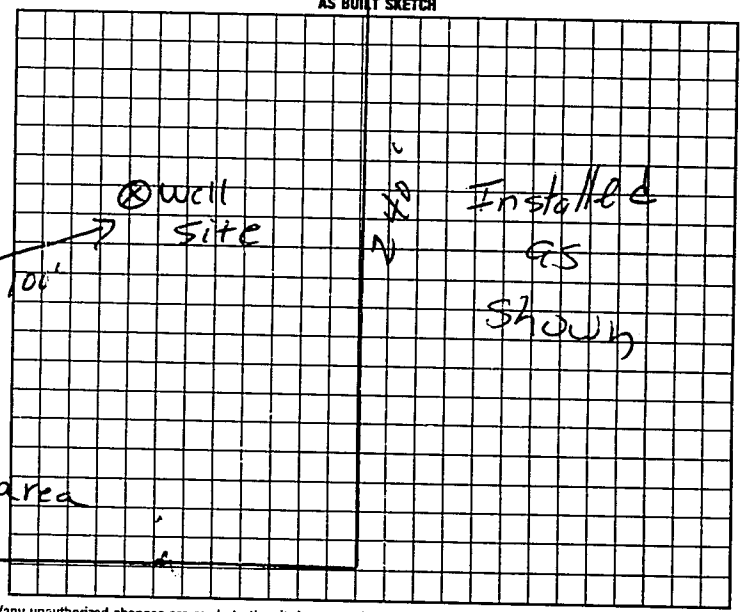

I understand that this permit can be suspended or revoked if any false information is supplied toward securing the permit/any unauthorized changes are made to the site/any unauthorized changes are made in the installation of the system. Improvement Permit is valid for 60 months from date of issuance.

Signed: _____

Improvement Permit by: L. C. Moore date 5-29-97

Authorization to Cover by: L. C. Moore date 5-29-97

Installed by: A-1 Backhoe

Certificate of Completion by: _____ date _____

Operation Permit by: Mary C Ostby RS date 6-11-97

Authorization to cover Expires 60 mos from issue

HEALTH DEPT. COPY: WHITE INSPECTION COPY (FINAL): GREEN OWNER COPY (FINAL): YELLOW INSPECTION COPY (INITIAL): PINK OWNER COPY (INITIAL): GOLD