IREDELL COUNTY HEALTH DEPARTMENT

STATESVILLE 704-878-5305 MOORESVILLE 704-664-5281

IMPROVEMENT PERMIT / AUTHORIZATION TO CONSTRUCT / OPERATION PERMIT / EXISTING SYSTEM INSPECTION

PERMIT# 091165 PIN# 4787346950 DATE 8/11/00

OWNER OR CONTRACTOR Gerald Stiltner PHONE: Business [redacted] Home (704) 873-7067

ADDRESS 143 Henderson Dr Statesville NC 28677

LOCATION 64E, L Cool SPRGS, R Hawks, L Bridge bottom .10 mi on Lt

SUBDIVISION — BLOCK / SECTION — LOT — LOT AREA 6.75 AC SITE CLASS PS DESIGN FLOW 360 L.T.A.R. 0.5

Septic Tank: 1000 Gallons; STB 1007 Date 8-8-00
Pump Tank: ____ Gallons; PT ____ Date ____
Pump Make: ____ Model ____ Serial No. ____
Nitrification Field: No Fields 1 Square Feet 1200 Linear Feet 400
No Lines 4 @ 100' Trench Width 36" Max Trench Bottom Depth 36"

[X] New System [ ] Repair System Type: I [X] II, IV, V, VI
System Description: Gravity Conventional
Repair System Description: Same
Maintenance Agreement Required: [ ] Yes [X] No
Gravel Depth 12" [ ] Slab [X] Crawl Space [ ] Basement w/plumbing [ ] Basement wo/plumbing


[ ] House/Mod. Home No. Bedrooms 3
[X] Mobile Home No. Bathrooms 2
[ ] Business No. Employees ____
[ ] Other ____

Water Supply:
[X] Individual
[ ] Public
[ ] Community


Comments/Conditions:

Comments/Conditions

INITIAL SITE SKETCH

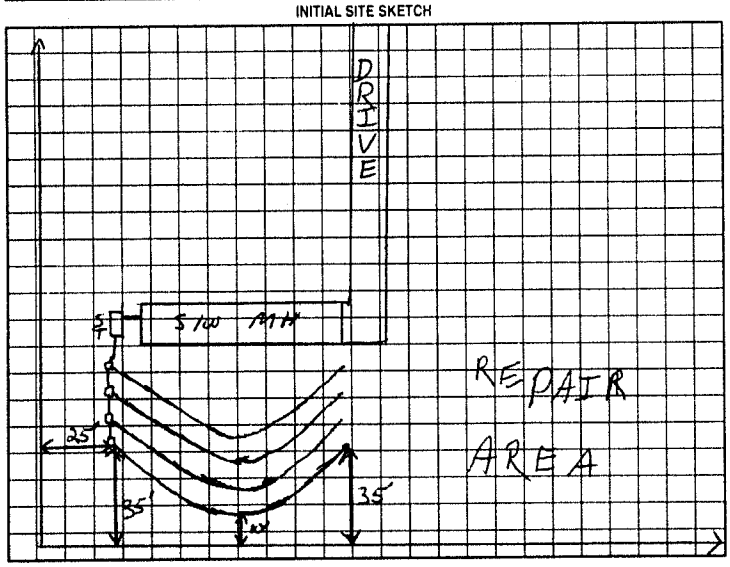

AS BUILT SKETCH

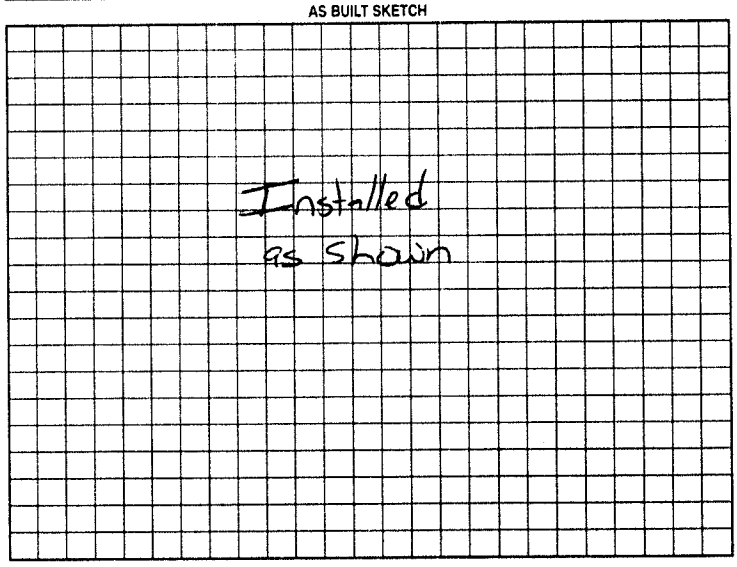

Permit can be suspended or revoked if any false information is supplied toward securing the permit/any unauthorized changes are made to the site/any unauthorized changes are made in the installation of the system. Improvement Permit with plat valid without expiration. Improvement Permit with site plan valid for sixty months. Authorization to Construct is valid for a period equal to that of Improvement Permit – not to exceed sixty months.

Signed: Kathy Mullins date 8/15/00

Improvement Permit by: RSI date 8/11/00

Authorization to Construct by: RSI date 8/11/00

Installed by: Scott Greene

Operation Permit by: [illegible] date 9-20-00

Existing System Inspection by: ____ date ____

HEALTH DEPT. COPY WHITE OWNER COPY (FINAL) YELLOW OWNER COPY (INITIAL) PINK