IREDELL COUNTY HEALTH DEPARTMENT

Statesville Office (704) 878-5305 Mooresville Office (704) 660-3625

IMPROVEMENT PERMIT / AUTHORIZATION TO CONSTRUCT / OPERATION PERMIT / EXISTING SYSTEM

PERMIT # 20196 9

PIN # 4787440042

APPLICANT: William Thrie

APPLICANT ADDRESS: 644 Cool Springs Rd Statesville NC 28625

SITE ADDRESS: 155 Hawks Rd Statesville NC 28625

PHONE: (704-878-9199 ALT. PHONE: W/A

SITE DIRECTIONS: 64 T/L Cool Springs T/R Hawks Rd Lot on left past curve

SUBDIVISION: N/A

SECTION: N/A LOT # N/A LOT AREA: 1ac

DESIGN FLOW: 240 L.T.A.R.: EX

Septic Tank	EX	(gal)	STB	EX	Date	EX	
Pump Tank	N/A	(gal)	PT	N/A	Date	N/A	
Pump Make	N/A	Model	N/A		Serial #	N/A	
# Nitrification Fields	1	# Lines	EX		Linear Ft:	EX	
Trench Width	EX	Max. Trench Bottom Depth	EX		Gravel Depth	EX	

☐ New System ☐ Repair ☐ Expansion System Type: I (II) III IV V VI

System Description: EXISTING

Repair System Description:

Maintenance Agreement Required: ☐ YES ☒ NO

☒ GRAVITY ☐ PRESSURE

☐ Residence ☐ Business ☐ Other ☐ Slab ☐ Basement w/plumbing

No. Bedrooms 2 No. Persons 4 No. Employees ☒ Crawl Space

☐ Basement w/o plumbing


Water Supply: ☒ Private ☐ Public ☐ Community

Comments / Conditions:

All building foundations must be ≥5' from any part of STS and ≥25' from any well.

INITIAL SITE SKETCH

AS BUILT SKETCH

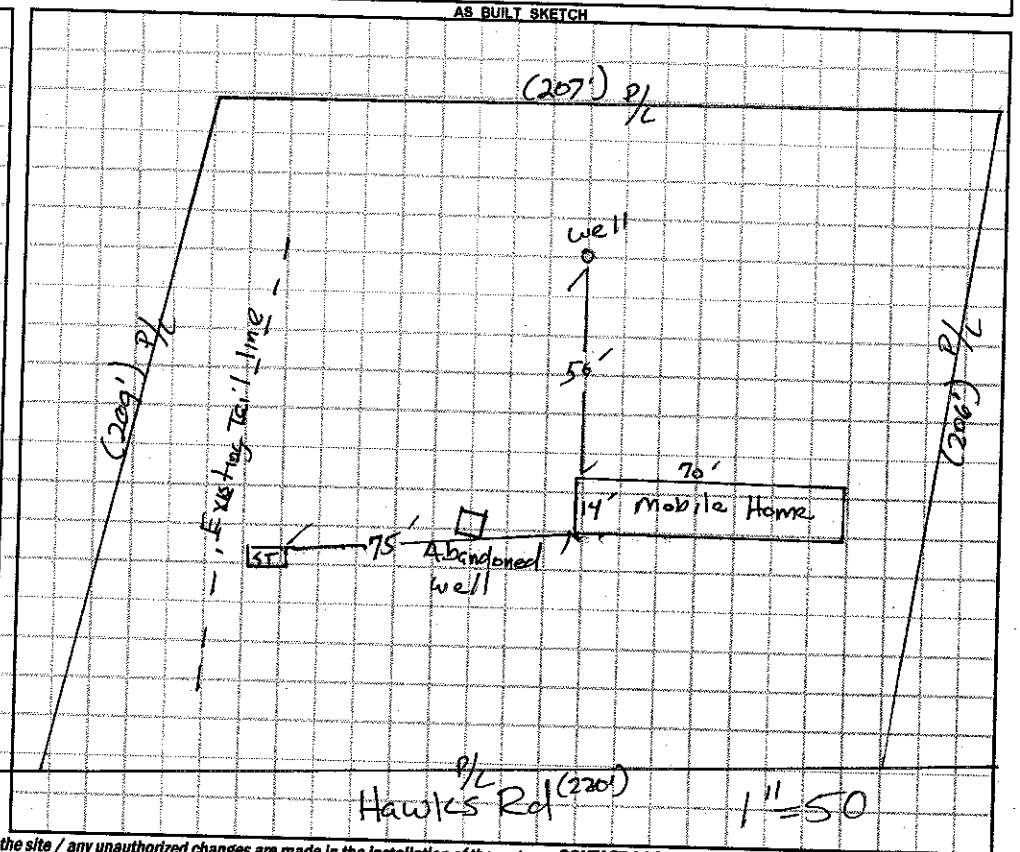

Permit can be suspended or revoked if any false information is supplied toward securing the permit / any unauthorized changes are made to the site / any unauthorized changes are made in the installation of the system. **CONTACT A LOCATOR SERVICE PRIOR TO ANY EXCAVATION**

☐ **IMPROVEMENT PERMIT** *with plat valid without expiration.* ☒ **IMPROVEMENT PERMIT** *with site plan valid for 60 mos.* ☐ **AUTHORIZATION TO CONSTRUCT** *valid for period equal to IMPROVEMENT PERMIT--not to exceed 60 mo.*

Owner / Applicant Signature: William Thrie Date: 4/7/14

IMPROVEMENT PERMIT by: Date:

AUTHORIZATION TO CONSTRUCT by: Date:

Installed by:

OPERATION PERMIT by: Date:

Existing System Inspected by: Date: 04/07/14

Health Dept. Copy - WHITE Applicant (Final Approval) - YELLOW Applicant (Conditional Approval) - PINK