IREDELL COUNTY HEALTH DEPARTMENT

STATESVILLE 704-878-5305 MOORESVILLE 704-664-5281

IMPROVEMENT PERMIT / CERTIFICATE OF COMPLETION / OPERATION PERMIT / EXISTING SYSTEM INSPECTION

PROPERTY DESCRIPTION NO. REPAIR DATE 5-4-96 TAX MAP NO.

OWNER OR CONTRACTOR ONA D. DRYE PHONE: Business LAWRENCE DRYE 872-3456 / 873-3935 Watershed: ☐ Yes ☒ No

ADDRESS 155 HAWKS LANE STATESVILLE, NC 28677

LOCATION US 64 E, TL COOLSPRINGS ROAD, R LIMITED, HAWKS LANE, 1ST ON LEFT PAST CURVE

SUBDIVISION BLOCK / SECTION LOT LOT AREA 1 SITE CLASS. P2 DESIGN FLOW 240 L.T.A.R. EXISTING

Septic Tank: EXISTING Gallons: STB Date

Pump Tank: Gallons: PT Date

Pump Make: Model Serial No.

Nitrification Field: No Fields 1 Square Feet 270 Linear Feet 90

No Lines 1 Trench Width 36" Max Trench Bottom Depth 36" Gravel Depth 24"

☒ New System ☒ Repair System Type: I, ☒ II, IV, V, VI

System Description: CONV. GRAVITY

Repair System Description: CONV. GRAVITY

Maintenance Agreement Required: ☐ Yes ☒ No

☒ House/Mod. Home No. Bedrooms 2

☐ Mobile Home No. Bathrooms 1

☐ Business No. Employees

☐ Other


☐ Slab ☐ Crawl Space ☐ Basement w/plumbing ☐ Basement wo/plumbing

Water Supply: ☒ Individual ☐ Community ☐ Public WELL

Comments: ① INSTALL NEW SANITARY TEE IN TANK
② INSTALL NEW 3" x 90' LINE USING 24" STONE

Comments:

INITIAL SITE SKETCH

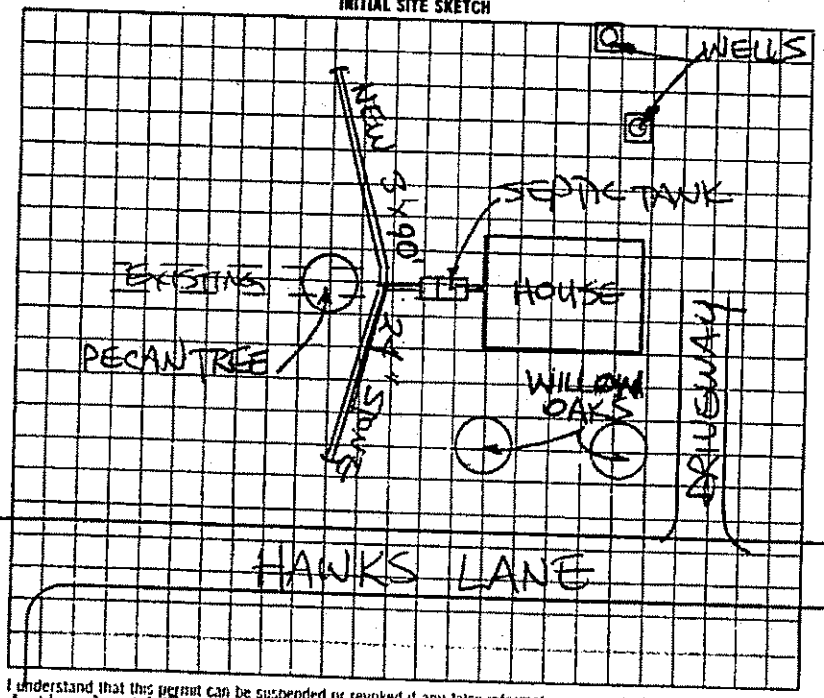

AS BUILT SKETCH

SYSTEM REPAIRED ACCORDING TO INITIAL SITE SKETCH

I understand that this permit can be suspended or revoked if any false information is supplied toward securing the permit/any unauthorized changes are made to the site/any unauthorized changes are made in the installation of the system. Authorization to Construct is valid five (5) years from date of issuance. Improvement Permit has no expiration date.

Signed: X Lawrence W. Drye

Improvement Permit by: STEVE HEDRICK date 5-4-96

Installed by: DONALD LACKEY

AUTHORIZATION TO CONSTRUCT: STEVE HEDRICK date 5-4-96

Certificate of Completion by: date

Operation Permit by: STEVE HEDRICK date 6-6-96

HEALTH DEPT. COPY, WHITE | INSPECTION COPY (FINAL) GREEN | OWNER COPY (FINAL) YELLOW | INSPECTION COPY (INITIAL) PINK | OWNER COPY (INITIAL) GOLD