IREDELL COUNTY HEALTH DEPARTMENT

STATESVILLE 704-878-5305 MOORESVILLE 704-664-5281

IMPROVEMENT PERMIT / AUTHORIZATION TO CONSTRUCT / OPERATION PERMIT / EXISTING SYSTEM INSPECTION

PERMIT# 66253 PIN# 4786 38 6434

OWNER OR CONTRACTOR Billy Hobbs

ADDRESS 315 Cool Springs Road PHONE: Business Home 873 2638

LOCATION 64E TL Cool Springs Rd on rt before 5th creek DATE 8-8-98

SUBDIVISION BLOCK / SECTION LOT 0 LOT AREA 1.92 acres SITE CLASS. PS DESIGN FLOW 240 L.T.A.R. 1.3

Septic Tank: 1000 Gallons; STB 794 Date 6-9-98

Pump Tank: Gallons; PT Date

Pump Make: Model Serial No.

Nitrification Field: No Fields 1 Square Feet 270 Linear Feet 135

No Lines 3 Trench Width 24" Max Trench Bottom Depth 36" Gravel Depth N/A

☑ New System ☐ Repair System Type: I, II, III, IV, V, VI

System Description: Gravity Panels

Repair System Description: Pump To Chambers

Maintenance Agreement Required: ☐ Yes ☑ No

☑ House/Mod. Home No. Bedrooms 2

☐ Mobile Home No. Bathrooms 2

☐ Business No. Employees

☐ Other

☐ Slab ☑ Crawl Space ☐ Basement w/plumbing ☐ Basement wo/plumbing


Water Supply: ☐ Individual ☑ Public ☐ Community

Comments:/Conditions:


Replaces Permit Issued 4-14-98

Comments:/Conditions:

INITIAL SITE SKETCH

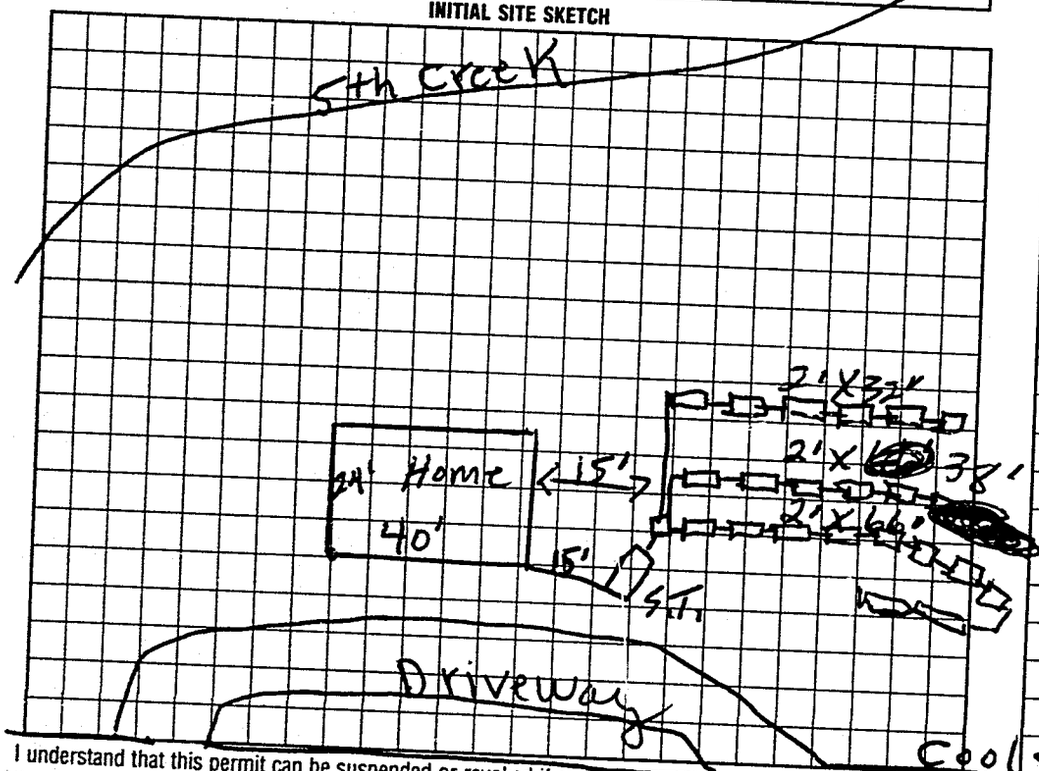

AS BUILT SKETCH

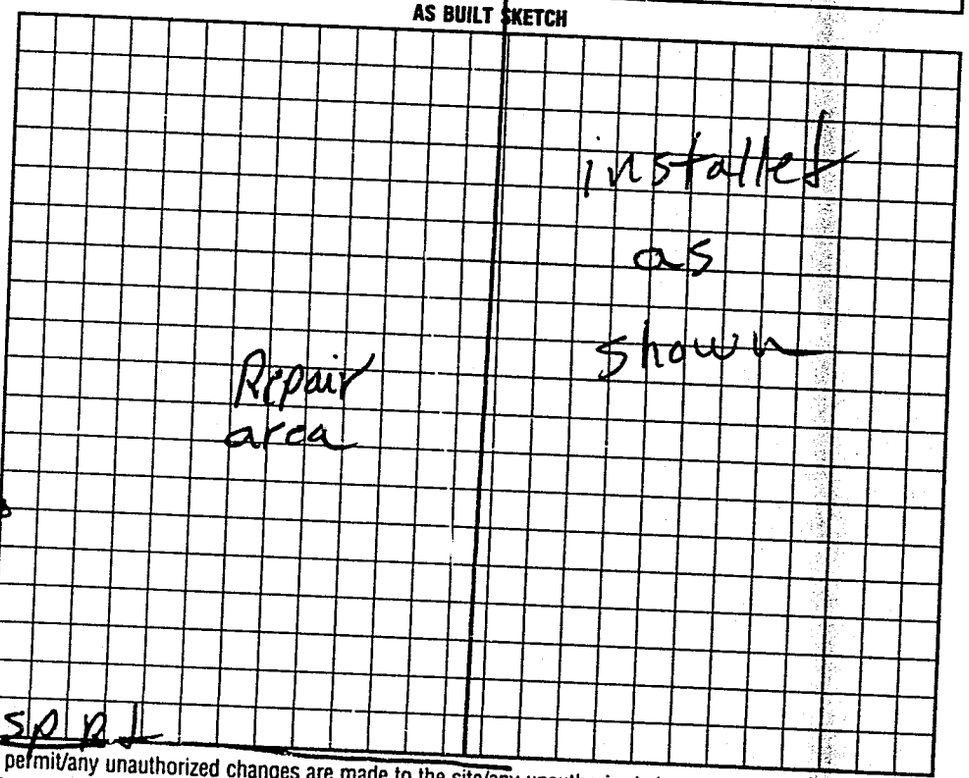

I understand that this permit can be suspended or revoked if any false information is supplied toward securing the permit/any unauthorized changes are made to the site/any unauthorized changes are made in the installation of the system. Improvement Permit with plat valid without expiration. Improvement Permit with site plan valid for sixty months. Authorization to Construct is valid for a period equal to that of Improvement Permit – not to exceed sixty months.

Signed: X

Improvement Permit by: F. C. Moore date 8-8-98

Authorization to Construct by: F. C. Moore date 8-8-98

Installed by: Harry Reep

Operation Permit by: F. C. Moore date 9-11-98

Existing System Inspection by: date

HEALTH DEPT. COPY: WHITE INSPECTION COPY (FINAL): GREEN OWNER COPY (FINAL): YELLOW INSPECTION COPY (INITIAL): PINK OWNER COPY (INITIAL): GOLD