IREDELL COUNTY HEALTH DEPARTMENT

STATESVILLE 704-878-5305 MOORESVILLE 704-664-5281

IMPROVEMENT PERMIT / AUTHORIZATION TO CONSTRUCT / OPERATION PERMIT / EXISTING SYSTEM INSPECTION

PERMIT# 72945 PIN# 4787 52 7004 DATE 4-21-98

OWNER OR CONTRACTOR Kyle Hinson PHONE: Business Home 924-7504

ADDRESS 244

LOCATION 64E TL 88 Cool Spring Rd TR Lossenhead Rd TR Back Ent Lu 1st Dr. Rt.

SUBDIVISION BLOCK / SECTION LOT LOT AREA 5.0 acres SITE CLASS. PS DESIGN FLOW 240 L.T.A.R. .3

Septic Tank: 1000 Gallons; STB 760 Date 1-26-99
Pump Tank: Gallons; PT Date
Pump Make: Model Serial No.
Nitrification Field: No Fields 1 Square Feet 800 Linear Feet 267
No Lines 3 Trench Width 36" Max Trench Bottom Depth 36 Gravel Depth 12"

☑ New System ☐ Repair System Type: I, II, III, IV, V, VI
System Description: Conv. Gravity
Repair System Description: Pump To Conv.
Maintenance Agreement Required: ☐ Yes ☐ No


☑ House/Mod. Home No. Bedrooms 2
☐ Mobile Home No. Bathrooms 2
☐ Business No. Employees
☐ Other
☐ Slab ☐ Crawl Space ☐ Basement w/plumbing ☐ Basement wo/plumbing

Water Supply: ☑ Individual ☐ Public ☐ Community


Comments:/Conditions: Ex well

Comments:/Conditions:

INITIAL SITE SKETCH

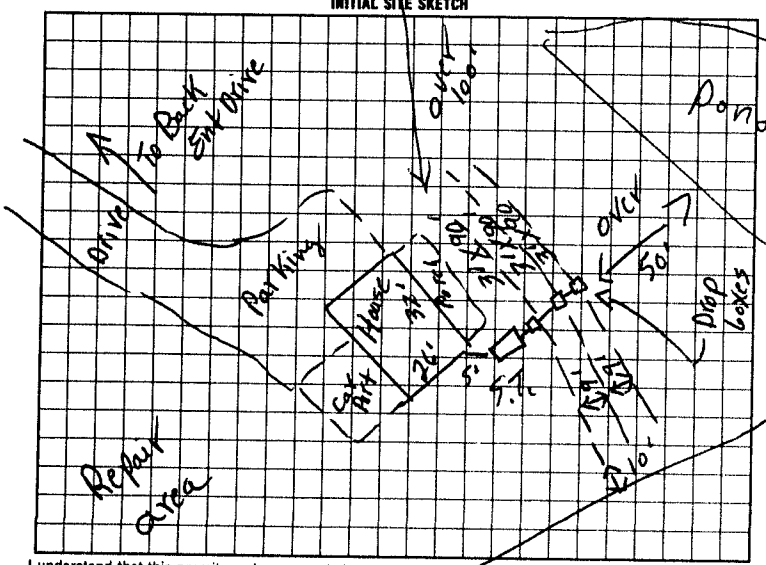

AS BUILT SKETCH

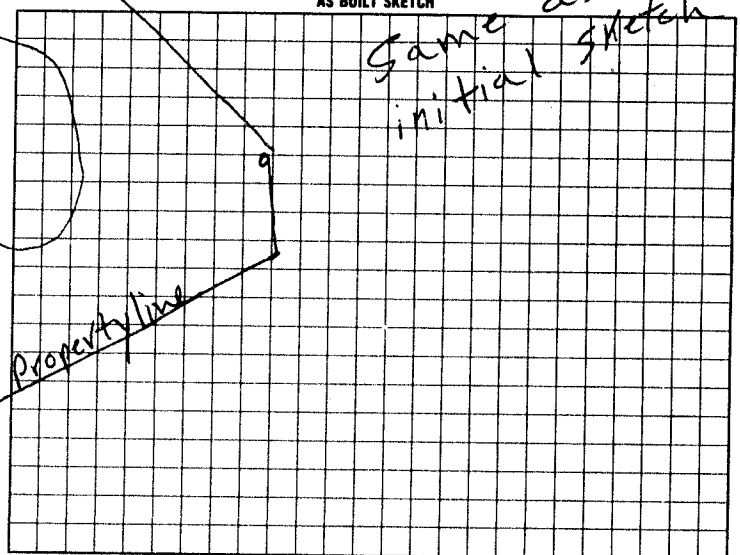

I understand that this permit can be suspended or revoked if any false information is supplied toward securing the permit/any unauthorized changes are made to the site/any unauthorized changes are made in the installation of the system. Improvement Permit with plat valid without expiration. Improvement Permit with site plan valid for sixty months. Authorization to Construct is valid for a period equal to that of Improvement Permit – not to exceed sixty months.

Signed: X Kyle Hinson date

Improvement Permit by: P.C. Moore date 4-21-98

Authorization to Construct by: P.C. Moore date 4-21-98

Installed by: D.L. Whitaker Grading (Davie Co.)

Operation Permit by: P.C. Moore date 3-19-99

Existing System Inspection by: date

HEALTH DEPT. COPY: WHITE INSPECTION COPY (FINAL): GREEN OWNER COPY (FINAL): YELLOW INSPECTION COPY (INITIAL): PINK OWNER COPY (INITIAL): GOLD