60621

IREDELL COUNTY HEALTH DEPARTMENT

STATESVILLE 704-878-5305 MOORESVILLE 704-664-5281

IMPROVEMENT PERMIT / CERTIFICATE OF COMPLETION / OPERATION PERMIT / EXISTING SYSTEM INSPECTION

PROPERTY DESCRIPTION NO. 23274 DATE 3-12-96 TAX MAP NO. 11K-3-A-9 Watershed: ☐ Yes ☑ No

OWNER OR CONTRACTOR Fil Pishner PHONE: Business Home 873-7130

ADDRESS PO Box 262 Harmony N.C. 28634

LOCATION 136 Horizon Dr. 1.6 E TL Coolspring TR Biggerhead TR Horizon Dr at end

SUBDIVISION Sunset village BLOCK / SECTION 2 LOT 9 LOT AREA .6 acres SITE CLASS PS DESIGN FLOW 360 L.T.A.R. .133

Septic Tank 1000 Gallons, STB 620 Date 3-16-96
Pump Tank ____ Gallons, PT ____ Date ____
Pump Make ____ Model ____ Serial No ____
Nitrification Field: No Fields 1 Square Feet 1080 Linear Feet 360
No Lines 4 Trench Width 36" Max Trench Bottom Depth 36" Gravel Depth 12"

☑ New System ☐ Repair System Type I II III IV V VI
System Description Conv. Gravity
Repair System Description ~~Gravity~~ PVMP Chambers
Maintenance Agreement Required Yes No


☑ House/Mod. Home No Bedrooms 3
☑ Mobile Home No Bathrooms 2
☐ Business No Employees ____
☐ Other ____
☑ Slab ☑ Crawl Space ☐ Basement w/plumbing ☐ Basement w/o plumbing

Water Supply:
☐ Individual
☐ Community
☐ Public


Comments:

Comments:
Community well Installed on backside of lot Repair area switched to front

INITIAL SITE SKETCH

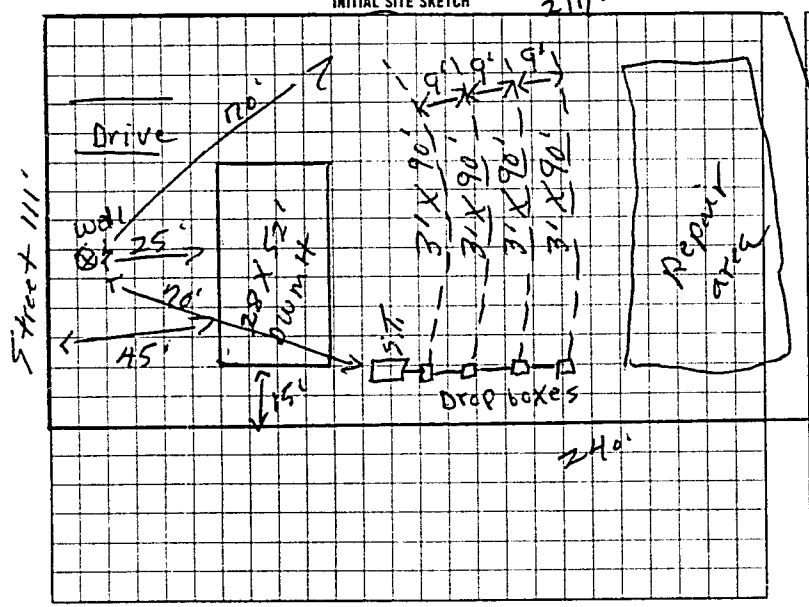

AS BUILT SKETCH

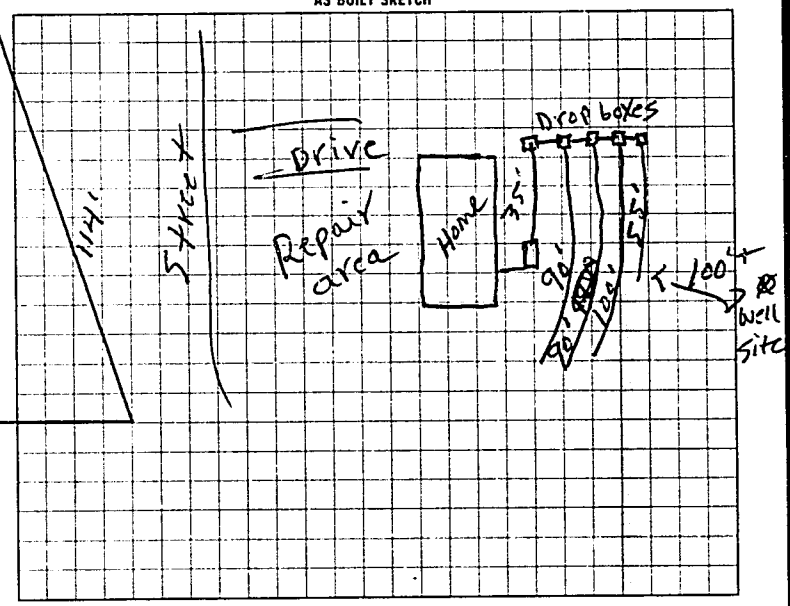

I understand that this permit can be suspended or revoked if any false information is supplied toward securing the permit/any unauthorized changes are made to the site/any unauthorized changes are made in the installation of the system

Signed Fil Pishner

Improvement Permit by P. C. Moore date 3-12-96

Authorization to Construct by P. C. Moore date 3-12-96

Installed by Sammy Reavis

Certificate of Completion by ____ date ____

Operation Permit by P. C. Moore date 5-30-96

HEALTH DEPT COPY WHITE INSPECTION COPY (FINAL) GREEN OWNER COPY (FINAL) YELLOW INSPECTION COPY (INITIAL) PINK OWNER COPY (INITIAL) GOLD

authorization to const Expires 60 mos From issue

998100