IREDELL COUNTY HEALTH DEPARTMENT

STATESVILLE 704-878-5305 MOORESVILLE 704-664-5281

IMPROVEMENT PERMIT / CERTIFICATE OF COMPLETION / OPERATION PERMIT / EXISTING SYSTEM INSPECTION

PROPERTY DESCRIPTION NO. 24156 DATE 6-22-96 TAX MAP NO. 11K-3-4-10 Watershed: ☐ Yes ☑ No

OWNER OR CONTRACTOR Fil Pishner PHONE: Business _____ Home 873-7130

ADDRESS PO Box 262 Harmony N.C.

LOCATION Hwy 64 East TL Cool Springs TR Lossenheal TR ~~Horizon~~ Dr. Denton Rd

SUBDIVISION Sunset Village BLOCK / SECTION _____ LOT 10 LOT AREA 1/10 acre SITE CLASS. PS DESIGN FLOW 360 L.T.A.R. .3

Septic Tank: 1000 Gallons; STB 794 Date 8-8-96

Pump Tank: _____ Gallons; PT _____ Date _____

Pump Make: _____ Model _____ Serial No. _____

Nitrification Field: No Fields 4 Square Feet 1200 Linear Feet 400

No Lines 4 Trench Width 36" Max Trench Bottom Depth 36" Gravel Depth 12"

☑ New System ☐ Repair System Type: I, II, III, IV, V, VI

System Description: Conv. Gravity

Repair System Description: " "

Maintenance Agreement Required: ☐ Yes ☑ No

☐ House/Mod. Home No. Bedrooms 3

☑ Mobile Home No. Bathrooms 2

☐ Business No. Employees _____

☐ Other _____


☐ Slab ☑ Crawl Space ☐ Basement w/plumbing ☐ Basement wo/plumbing

Water Supply: ☐ Individual ☑ Community ☐ Public

Comments:

Comments: Mobile Home Not on Site at Time of This inspection

INITIAL SITE SKETCH

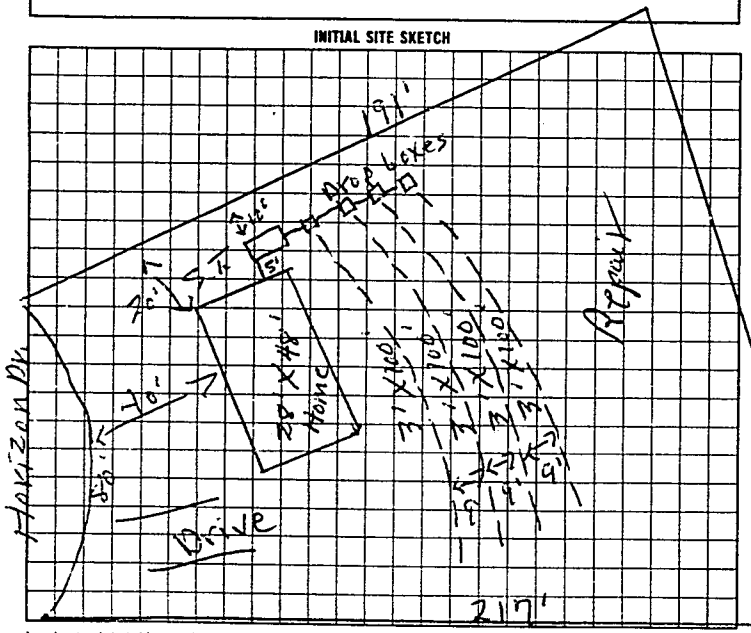

AS BUILT SKETCH

Same as initial sketch

I understand that this permit can be suspended or revoked if any false information is supplied toward securing the permit/any unauthorized changes are made to the site/any unauthorized changes are made in the installation of the system.

Signed: Fil Pishner

Improvement Permit by: R. C. Moore date 6-22-96

Existing System Inspection by: R. C. Moore date 6-22-96

Authorization to Count

Installed by: James Hutler

Certificate of Completion by: _____ date _____

Operation Permit by: R. C. Moore date 10-14-96

HEALTH DEPT COPY WHITE INSPECTION COPY (FINAL) GREEN OWNER COPY (FINAL) YELLOW INSPECTION COPY (INITIAL) PINK OWNER COPY (INITIAL) GOLD

Authorization to Count Expires 6 mos from issue

0 2 8 1 0 0