IREDELL COUNTY HEALTH DEPARTMENT

Authorization to construct

Sam Reaves 10:30

STATESVILLE 704-878-5305 MOORESVILLE 704-664-5281

IMPROVEMENT PERMIT / ~~CERTIFICATE OF COMPLETION~~ / OPERATION PERMIT / EXISTING SYSTEM INSPECTION

PROPERTY DESCRIPTION NO. 85405 DATE 11-6-96 TAX MAP NO. 11K-3-A-1 Watershed: ☐ Yes ☒ No

OWNER OR CONTRACTOR Fil Pushner PHONE: Business Home 873-7130

ADDRESS 136 Horizon Dr Statesville NC

LOCATION 64E TL Coulsprings Rd TR Loggerhead Rd ~400 yards on Right Before Horizon Dr

SUBDIVISION Sunset Village BLOCK / SECTION LOT 1 LOT AREA SITE CLASS. P/S DESIGN FLOW 360 L.T.A.R. 0.3

Septic Tank: 1000 Gallons; STB 6020 CRS Date 5/20/97

Pump Tank: Gallons; PT Date

Pump Make: Model Serial No.

Nitrification Field: No Fields 1 Square Feet 1200 Linear Feet 400

No Lines 5 Trench Width 36in Max Trench Bottom Depth 36in Gravel Depth 12in

☒ New System ☐ Repair System Type: I, II, III, IV, V, VI

System Description: Gravity Conventional

Repair System Description: Gravity Chamber

Maintenance Agreement Required: ☐ Yes ☒ No

☐ House/Mod. Home No. Bedrooms 3

☒ Mobile Home No. Bathrooms 2

☐ Business No. Employees

☐ Other

☐ Slab ☒ Crawl Space ☐ Basement w/plumbing ☐ Basement wo/plumbing


Water Supply: ☐ Individual ☒ Community ☐ Public

Comments: Keep lines on contour, 9ft on center


Smoothout Terrace

Comments:

INITIAL SITE SKETCH

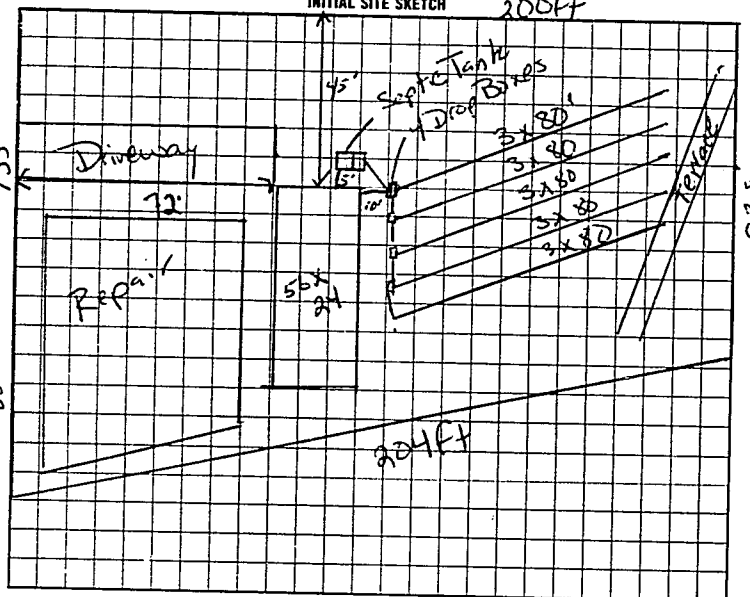

AS BUILT SKETCH

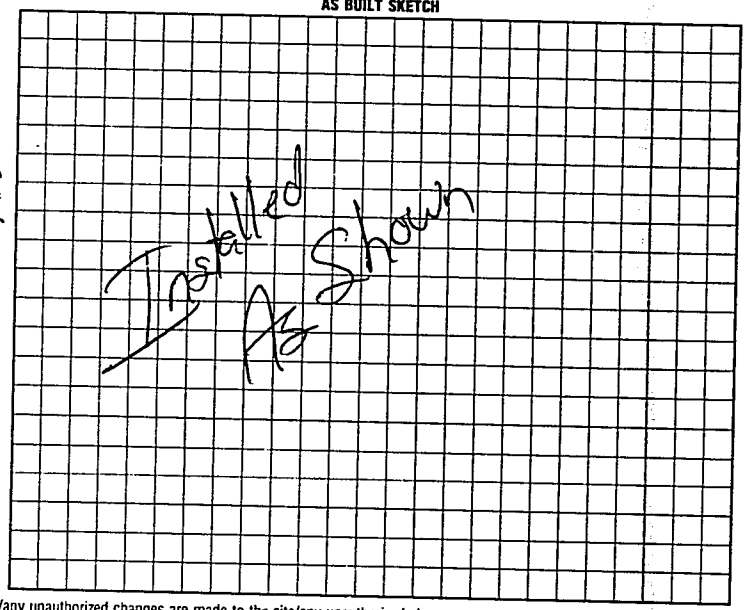

I understand that this permit can be suspended or revoked if any false information is supplied toward securing the permit/any unauthorized changes are made to the site/any unauthorized changes are made in the installation of the system.

Authorization to construct expires 5yrs after issue date

Signed: X Fil Pushner

Improvement Permit by: Mark C Ott RS date 11-6-96

~~Authorization to Const~~ Mark C Ott RS date 11-6-96

Installed by: Sammy Reaves

Certificate of Completion by:

Operation Permit by: date

date 8/7/97

HEALTH DEPT COPY: WHITE INSPECTION COPY (FINAL): GREEN OWNER COPY (FINAL): YELLOW INSPECTION COPY (INITIAL): PINK OWNER COPY (INITIAL): GOLD