IREDELL COUNTY HEALTH DEPARTMENT

STATESVILLE 704-878-5305 MOORESVILLE 704-664-5281

60620

IMPROVEMENT PERMIT / CERTIFICATE OF COMPLETION / OPERATION PERMIT / EXISTING SYSTEM INSPECTION

PROPERTY DESCRIPTION NO. 23721 DATE 3-12-96 TAX MAP NO. 11 K-3-A-2 Watershed: ☐ Yes ☑ No

OWNER OR CONTRACTOR Fil Pishner PHONE: Business Home 873-7230

ADDRESS PO Box 262 Harmony N.C.

LOCATION 64E TL cool Sp Rd TR Loggerhead on Rt before Horizon Dr.

SUBDIVISION Sunset village BLOCK / SECTION LOT 2 LOT AREA 125'x200' SITE CLASS PS DESIGN FLOW 360 L.T.A.R. .13

Septic Tank 1000 Gallons; STB G20 Date 3-14-96
Pump Tank Gallons; PT Date
Pump Make Model Serial No
Nitrification Field: No Fields 1 Square Feet 1200 Linear Feet 400
No Lines 4 Trench Width 36" Max Trench Bottom Depth 36" Gravel Depth 12"

☑ New System ☐ Repair System Type I II III IV V VI
System Description conv. Gravity
Repair System Description Panel "
Maintenance Agreement Required Yes ☐ No ☑
Slab ☑ Crawl Space Basement w/plumbing Basement wo/plumbing


House/Mod. Home No Bedrooms 3
☑ Mobile Home No Bathrooms 2
Business No Employees
Other

☑ Water Supply ☑ Individual ☐ Community ☐ Public


Comments:

Comments:

INITIAL SITE SKETCH

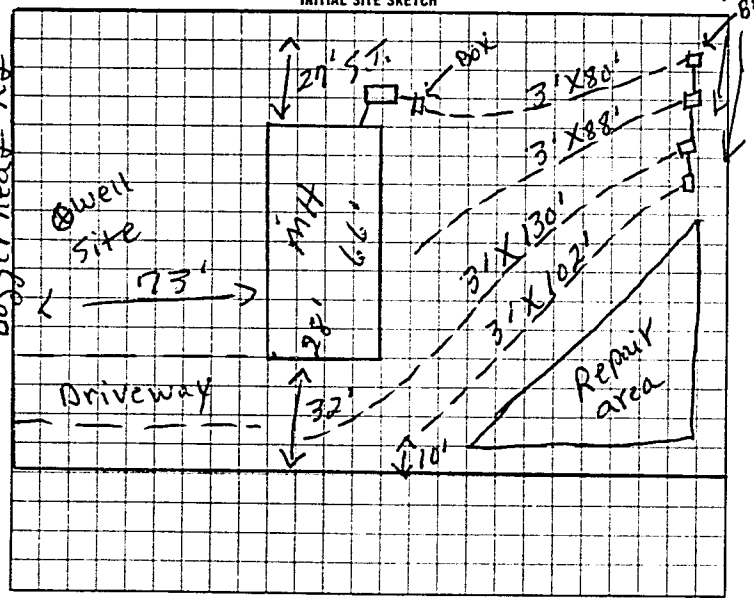

AS BUILT SKETCH

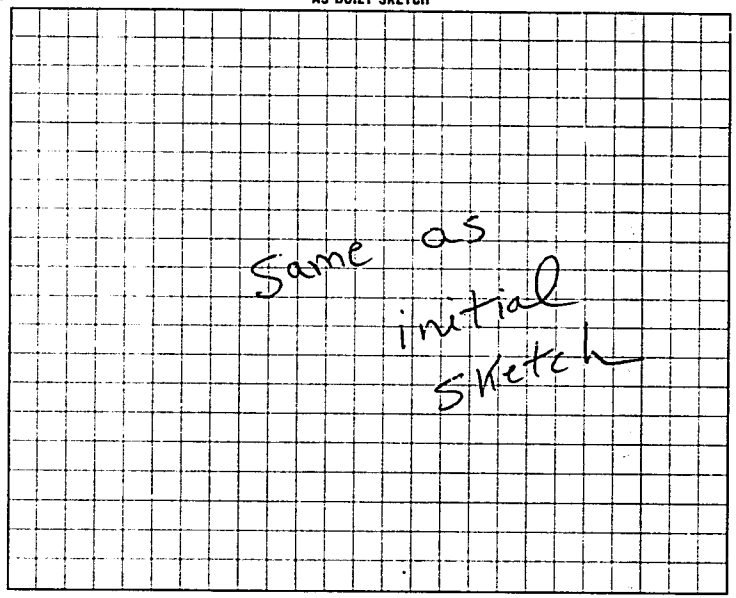

I understand that this permit can be suspended or revoked if any false information is supplied toward securing the permit/any unauthorized changes are made to the site/any unauthorized changes are made in the installation of the system

Signed Fil Pishner

Improvement Permit by L. C. moore date 3-12-96

~~Authorization~~ Existing system inspection by L. C. moore date 3-12-96

Installed by Sammy Reavis

Certificate of Completion by date

Operation Permit by L. C. moore date 5-30-96

to cover HEALTH DEPT. COPY WHITE INSPECTION COPY (FINAL) GREEN OWNER COPY (FINAL) YELLOW INSPECTION COPY (INITIAL) PINK OWNER COPY (INITIAL) GOLD

authorization to cover Expires 60 mos from issue