60620

60623

IREDELL COUNTY HEALTH DEPARTMENT

STATESVILLE 704-878-5305 MOORESVILLE 704-664-5281

IMPROVEMENT PERMIT / CERTIFICATE OF COMPLETION / OPERATION PERMIT / EXISTING SYSTEM INSPECTION

PROPERTY DESCRIPTION NO. 22687 DATE 4-10-96 TAX MAP NO. 11K-3-A-5 Watershed: ☐ Yes ☐ No

OWNER OR CONTRACTOR Filbert Pishner PHONE: Business Home 873 7130

ADDRESS PO BOX 767 Statesville

LOCATION 64E TL cool Sp. Rd TR Loggerhead TR Sunset 600' Rt

SUBDIVISION Sunset village BLOCK / SECTION LOT 5 LOT AREA 1.723 acres SITE CLASS. PS DESIGN FLOW 360 L.T.A.R.

Septic Tank: 1000 Gallons; STB 620 Date 3-10-96
Pump Tank: Gallons; PT Date
Pump Make: Model Serial No.
Nitrification Field: No Fields 1 Square Feet 1200 Linear Feet 406
No Lines 4 Trench Width 36" Max Trench Bottom Depth 36" Gravel Depth 12"

☐ New System ☐ Repair System Type: I, II, III, IV, V, VI
System Description: Conv. Gravity
Repair System Description:
Maintenance Agreement Required: ☐ Yes ☐ No


☐ House/Mod. Home No. Bedrooms 3
☐ Mobile Home No. Bathrooms 2
☐ Business No. Employees
☐ Other
☐ Slab ☐ Crawl Space ☐ Basement w/plumbing ☐ Basement w/o plumbing

Water Supply: ☐ Individual ☐ Community ☐ Public


Comments:

Comments:

INITIAL SITE SKETCH

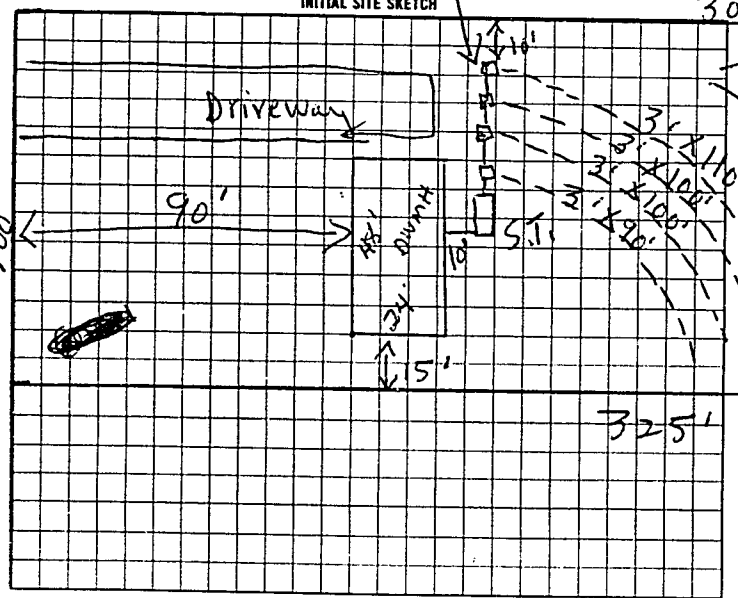

AS BUILT SKETCH

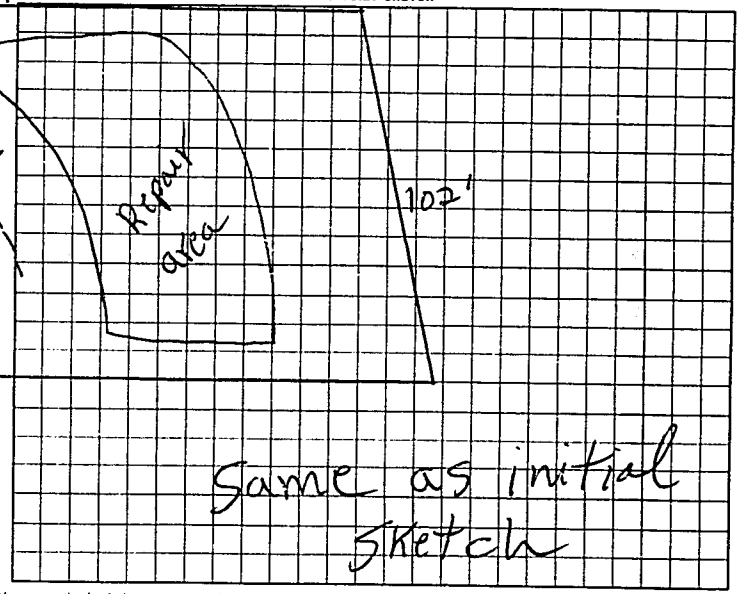

Same as initial sketch

I understand that this permit can be suspended or revoked if any false information is supplied toward securing the permit/any unauthorized changes are made to the site/any unauthorized changes are made in the installation of the system.

Signed: x Fil Pishner

Improvement Permit by: P.C. Moore date 4-10-96

Existing System Inspection by: P.C. Moore date 4-10-96

Installed by: Sammy Reavis

Certificate of Completion by: date

Operation Permit by P.C. Moore date 5-23-96

TO CONTRACTOR DEPT COPY WHITE INSPECTION COPY (FINAL) GREEN OWNER COPY (FINAL) YELLOW INSPECTION COPY (INITIAL) PINK OWNER COPY (INITIAL) GOLD

Authorization to const. Expires 6 mos from issue

00198 2