IREDELL COUNTY HEALTH DEPARTMENT

STATESVILLE 704-878-5305 MOORESVILLE 704-664-5281

400

IMPROVEMENT PERMIT / CERTIFICATE OF COMPLETION / OPERATION PERMIT / EXISTING SYSTEM INSPECTION

PROPERTY DESCRIPTION NO. 23272 DATE 3-12-96 TAX MAP NO. 11K-3-A-7 Watershed: ☐ Yes ☐ No

OWNER OR CONTRACTOR Fil Pishner PHONE Business _____ Home 873-7130

ADDRESS PO BOX 262 Harmony N.C.

LOCATION 64 E TL Cecil Sp. Rd TR / Waggerhead TR Horizon Drive [redacted] adjacent lot 126 Horizon Dr.

SUBDIVISION Sunset Village BLOCK / SECTION _____ LOT 7 LOT AREA .163 acres SITE CLASS PS DESIGN FLOW 300 L.T.A.R. .3

Septic Tank 1000 Gallons: STB 620 Date 12-12-96

Pump Tank _____ Gallons: PT _____ Date _____

Pump Make _____ Model _____ Serial No. _____

Nitrification Field No. Fields 1 Square Feet 1200 Linear Feet 400

No. Lines 4 Trench Width 36 Max Trench Bottom Depth 36 Gravel Depth 12"

~~New System~~ Repair System Type I (II) III IV V VI

System Description Conv. Gravity

Repair System Description Gravity Panel

Maintenance Agreement Required Yes ~~No~~

~~House/Mod Home~~ Mobile Home Business Other

No. Bedrooms 3 No. Bathrooms 2 No. Employees _____


Slab ~~Crawl Space~~ Basement w/plumbing Basement wo/plumbing

Water Supply ~~Individual~~ ☐ Community ☐ Public


Comments

Comments: Hooking To Community well Not using well site

INITIAL SITE SKETCH

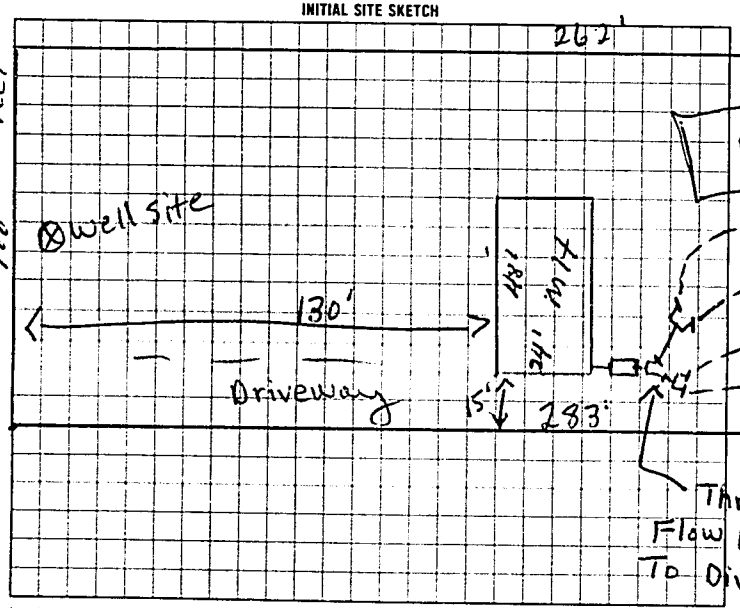

AS BUILT SKETCH

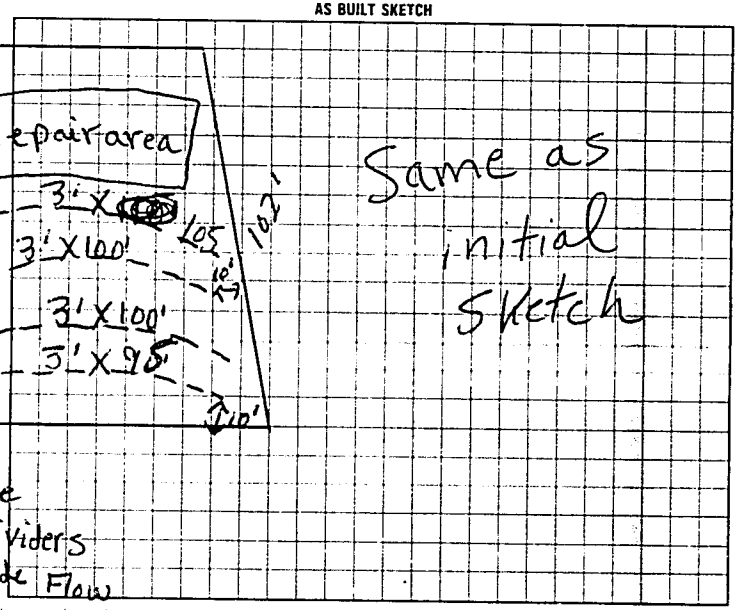

I understand that this permit can be suspended or revoked if any false information is supplied toward securing the permit/any unauthorized changes are made to the site/any unauthorized changes are made in the installation of the system.

Signed Fil Pishner

Improvement Permit by: F. C. Moore date 3-12-96

Existing System Inspection by: F. C. Moore date 3-12-96

Court HEALTH DEPT COPY (GOLD) INSPECTION COPY (PINK) OWNER COPY (PINK) YELLOW

Installed by Sammy Reavis

Certificate of Completion by: _____ date _____

Operation Permit by F. C. Moore date 2-7-97

INSPECTION COPY (INITIAL) PINK OWNER COPY (INITIAL) GOLD

Authorization to Court. Expires 60 mos From Issue

5 7 8 1 0 0