61444

# IREDELL COUNTY HEALTH DEPARTMENT

STATESVILLE 704-878-5305 MOORESVILLE 704-664-5281

## IMPROVEMENT PERMIT / CERTIFICATE OF COMPLETION / OPERATION PERMIT / EXISTING SYSTEM INSPECTION

PROPERTY DESCRIPTION NO. 23970 DATE 5-24-96 TAX MAP NO. 11K-3-A-70 Watershed: ☐ Yes ☑ No

OWNER OR CONTRACTOR Fil Fisher PHONE: Business Home 873-7130

ADDRESS PO Box 362 Harmony N.C. 28634

LOCATION 64E TL Cool Spring Rd TR Lossen Heat TR Horizon Dr 400' LOT

SUBDIVISION Sunset Hills BLOCK / SECTION LOT 20 LOT AREA 100'X254' SITE CLASS. PS DESIGN FLOW 360 L.T.A.R. .72

Septic Tank: 1000 Gallons; STB 620 Date 4-3-96

Pump Tank: Gallons; PT Date

Pump Make: Model Serial No.

Nitrification Field: No Fields 1 Square Feet 1110 Linear Feet 370

No Lines 3 Trench Width 36" Max Trench Bottom Depth 36" Gravel Depth 12"

☑ New System ☐ Repair System Type: I, II, III, IV, V, VI

System Description: Conv. Gravity

Repair System Description: Gravity Chambers

Maintenance Agreement Required: ☐ Yes ☐ NO

☐ House/Mod. Home No. Bedrooms 3

☑ Mobile Home No. Bathrooms 2

☐ Business No. Employees

☐ Other


☐ Slab ☑ Crawl Space ☐ Basement w/plumbing ☐ Basement wo/plumbing

Water Supply: ☑ Individual ☐ Community ☐ Public


Comments:

Comments: well & mtr were not on site at time of inspection

INITIAL SITE SKETCH

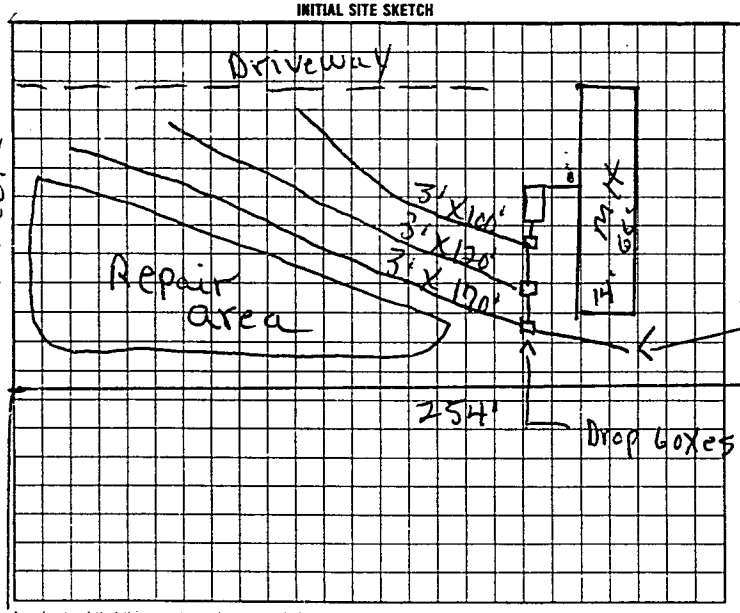


AS BUILT SKETCH

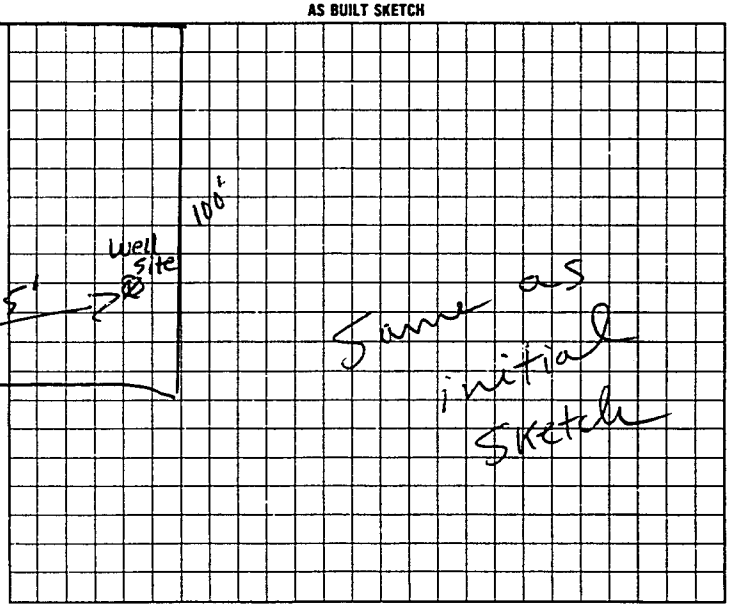


I understand that this permit can be suspended or revoked if any false information is supplied toward securing the permit/any unauthorized changes are made to the site/any unauthorized changes are made in the installation of the system.

Signed: Fil Fisher

Improvement Permit by: L.C. Moore date 5-24-96

Authorization to Construct by: L.C. moore date 5-24-96

Installed by: Sammy Reavis

Certificate of Completion by: date

Operation Permit by: L.C. Moore date 5-31-96

BLUE-DEPT COPY WHITE INSPECTION COPY (FINAL) GREEN OWNER COPY (FINAL) YELLOW INSPECTION COPY (INITIAL) PINK OWNER COPY (INITIAL) GOLD

Authorization to Construct Expires 60 mos from issue

5 2 8 1 0 0