IREDELL COUNTY HEALTH DEPARTMENT

STATESVILLE 704-878-5305 MOORESVILLE 704-664-5281

IMPROVEMENT PERMIT / AUTHORIZATION TO CONSTRUCT / OPERATION PERMIT / EXISTING SYSTEM INSPECTION

PERMIT# Repair PIN# 4787 53 7782 DATE 3-27-01

OWNER OR CONTRACTOR David + Ruth Pishner PHONE: Business — Home (704) 873-0125

ADDRESS 219 Logger Lee Rd Statesville NC 28677

LOCATION 64E to Coal Spring Rd (R) Logger Head Rd. 3rd Cotage (R) Port Horizon St

SUBDIVISION Sunset Village BLOCK / SECTION — LOT 23 LOT AREA — SITE CLASS. 1 3 DESIGN FLOW 360 L.T.A.R. .35

Septic Tank: Berry 1000 Gallons: STB — Date —

Pump Tank: — Gallons; PT — Date —

Pump Make: — Model — Serial No. — Pump Out Now

Nitrification Field: No Fields / Square Feet — Linear Feet 270'

No Lines — Trench Width 36" Max Trench Bottom Depth 30" Gravel Depth 12"

☐ New System ☒ Repair System Type: I (II) III. IV. V. VI

System Description: Conv. / Gravity

Repair System Description: Conv. Gravity

Maintenance Agreement Required: ☐ Yes ☒ No

☐ House/Mod. Home ☒ Mobile Home ☐ Business ☐ Other

No. Bedrooms 3 No. Bathrooms 2 No. Employees —


☐ Slab ☒ Crawl Space ☐ Basement w/plumbing ☐ Basement wo/plumbing

Water Supply: ☒ Individual ☐ Public ☐ Community

Comments/Conditions: (1) Add (3) 3'x 90' lines to existing system on contour (2) Keep 10ft from property Lines (4) System Lines must be 15'ft from pool (5) Disconnect top 3 septic Lines because of Swimming Pool

Comments/Conditions:

INITIAL SITE SKETCH

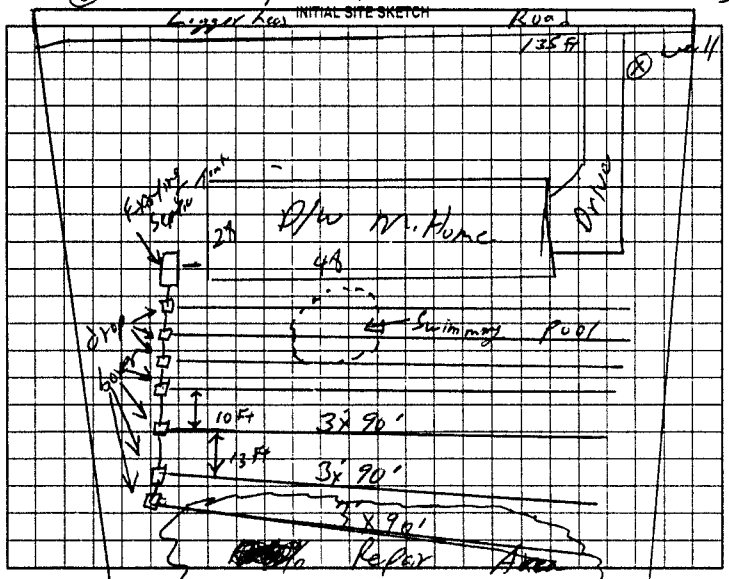

AS BUILT SKETCH

Installed as Per Initial Site Sketch

Permit can be suspended or revoked if any false information is supplied toward securing the permit/any unauthorized changes are made to the site/any unauthorized changes are made in the installation of the system. Improvement Permit with plat valid without expiration. Improvement Permit with site plan valid for sixty months. Authorization to Construct is valid for a period equal to that of Improvement Permit, not to exceed sixty months.

Signed: Ruth Pishner date 3/28/01 Installed by: Grubb Grading + Hauling

Improvement Permit by: William G. Johnson RSI date 3/28/01 Operation Permit by: William G. Johnson date 4/12/01

Authorization to Construct by: William G. Johnson RSI date 3/28/01 Existing System Inspection by: — date —

HEALTH DEPT COPY WHITE OWNER COPY (FINAL) YELLOW OWNER COPY (INITIAL) PINK