IREDELL COUNTY HEALTH DEPARTMENT

STATESVILLE 704-878-5305 MOORESVILLE 704-664-5281

~~56068~~ 56508

IMPROVEMENT PERMIT / CERTIFICATE OF COMPLETION / OPERATION PERMIT / EXISTING SYSTEM INSPECTION

PROPERTY DESCRIPTION NO. 21338 DATE 6-14-95 TAX MAP NO. 11K-A 19A Watershed: ☐ Yes ☐ No

OWNER OR CONTRACTOR Filbert W. Fishner PHONE: Business Home 873-7130

ADDRESS PO Box 262 Harmony NC

LOCATION 64E 70 cool Spring Rd TR beggerhead Part 1st Rt 3rd lot Rt

SUBDIVISION Sunset Village BLOCK / SECTION LOT 23 LOT AREA +-5 Acres SITE CLASS. PJ DESIGN FLOW 360 L.T.A.R. .375

Septic Tank: 1000 Gallons; STB 620 Date 4-22-95

Pump Tank: Gallons; PT Date

Pump Make: Model Serial No.

Nitrification Field: No Fields 1 Square Feet 1080 Linear Feet 360

No Lines 4 Trench Width 36" Max Trench Bottom Depth 31" Gravel Depth 12"

☑ New System ☐ Repair System Type: I II III IV V VI

System Description: conv. Gravity

Repair System Description:

Maintenance Agreement Required: ☐ Yes ☑ No

☐ House/Mod. Home ☑ Mobile Home ☐ Business ☐ Other

No. Bedrooms 3 No. Bathrooms 2 No. Employees


☐ Slab ☐ Crawl Space ☐ Basement w/plumbing ☐ Basement wo/plumbing

Water Supply: ☑ Individual ☐ Community ☐ Public


Comments:

Comments:

INITIAL SITE SKETCH

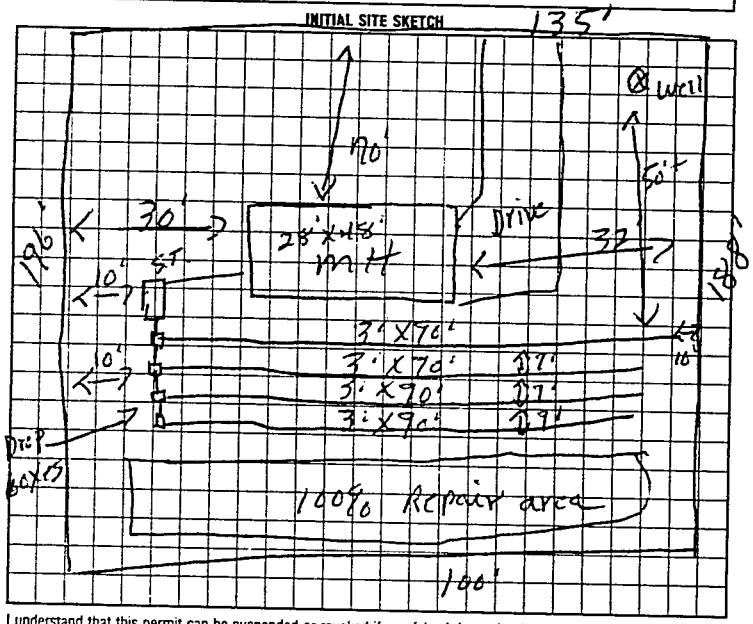

AS BUILT SKETCH

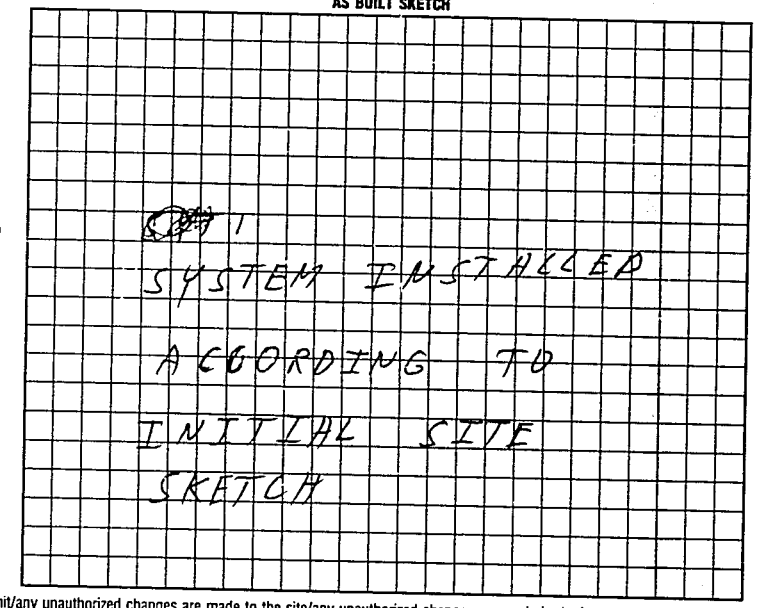

I understand that this permit can be suspended or revoked if any false information is supplied toward securing the permit/any unauthorized changes are made to the site/any unauthorized changes are made in the installation of the system. Improvement Permit is valid for 60 months from date of issuance.

Signed: Fil Fishner

Improvement Permit by: P.C. Moore date 6-14-95

Existing System Inspection by: date

Installed by:

Certificate of Completion by: STEVE HEDRICK date 7-6-95

Operation Permit by: date

HEALTH DEPT. COPY: WHITE INSPECTION COPY (FINAL): GREEN OWNER COPY (FINAL): YELLOW INSPECTION COPY (INITIAL): PINK OWNER COPY (INITIAL): GOLD

L 8 7 L 0 0