57555

IREDELL COUNTY HEALTH DEPARTMENT

STATESVILLE 704-878-5305 MOORESVILLE 704-664-5281

IMPROVEMENT PERMIT / CERTIFICATE OF COMPLETION / OPERATION PERMIT / EXISTING SYSTEM INSPECTION

PROPERTY DESCRIPTION NO. 22103 DATE 9-13-95 TAX MAP NO. 11K-3-A-19 Watershed: ☐ Yes ☐ No

OWNER OR CONTRACTOR Don + Debra meadows PHONE: Business Home 634-1483

ADDRESS 219 McCullough Rd mocksville

LOCATION 64E To Cool Sp Rd TR Lasserheat TR Horizon Dr 3rd lot left

SUBDIVISION Sunset village BLOCK / SECTION LOT 19 LOT AREA .76 acres SITE CLASS. PS DESIGN FLOW 360 L.T.A.R. 0.3

Septic Tank: 1000 Gallons; STB 794 Date 6-28-95

Pump Tank: Gallons; PT Date

Pump Make: Model Serial No.

Nitrification Field: No Fields 1 Square Feet 1200 Linear Feet 400

No Lines 4 Trench Width 36" Max Trench Bottom Depth 36" Gravel Depth 12"

☑ New System ☐ Repair System Type: ☐ I ☑ II ☐ III, IV, V, VI

System Description: Conv. Gravity

Repair System Description: " "

Maintenance Agreement Required: ☐ Yes ☑ No

☐ House/Mod. Home No. Bedrooms 3

☐ Mobile Home No. Bathrooms 2

☐ Business No. Employees

☐ Other


☐ Slab ☑ Crawl Space ☐ Basement w/plumbing ☐ Basement wo/plumbing

Water Supply: ☑ Individual ☐ Community ☐ Public


Comments:

Comments: mtr + well Not on site at Time of This inspection

INITIAL SITE SKETCH

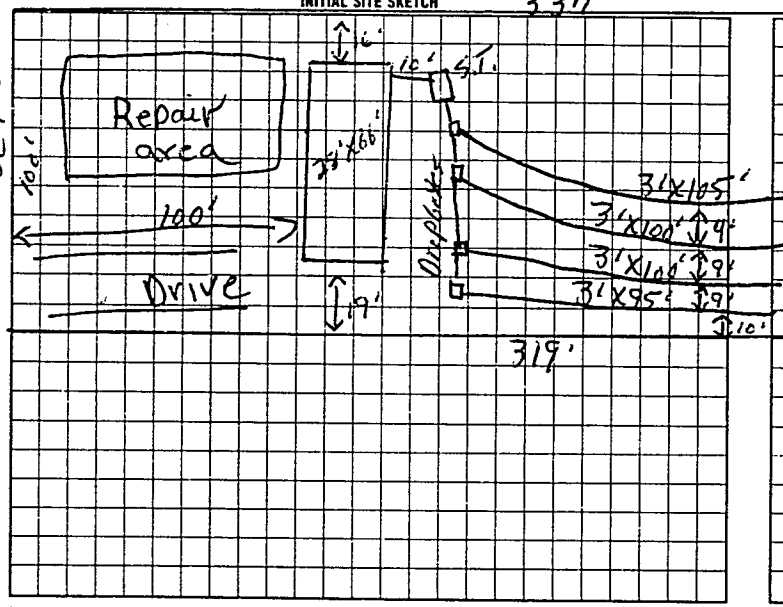

AS BUILT SKETCH

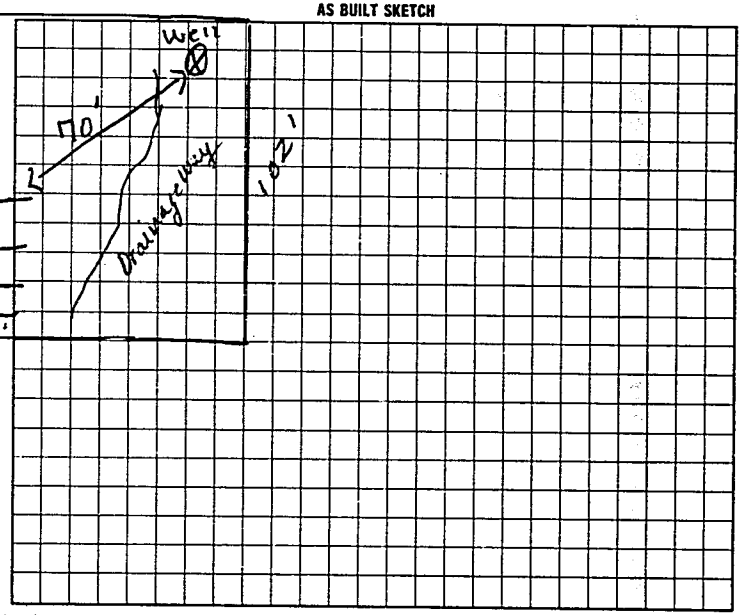

I understand that this permit can be suspended or revoked if any false information is supplied toward securing the permit/any unauthorized changes are made to the site/any unauthorized changes are made in the installation of the system.

Signed: x Debra Meadows

Improvement Permit by: E. C. Moore date 9-13-95

Existing System Inspection by: date

Installed by: Cody C.O. (Denver N.C.)

Certificate of Completion by: date 10-2-95

Operation Permit by: E. C. Moore date 10-2-95

HEALTH DEPT COPY WHITE — INSPECTION COPY (FINAL) GREEN — OWNER COPY (FINAL) YELLOW — INSPECTION COPY (INITIAL) PINK — OWNER COPY (INITIAL) GOLD