IREDELL COUNTY HEALTH DEPARTMENT

STATESVILLE 704-878-5305 MOORESVILLE 704-664-5281

IMPROVEMENT PERMIT / AUTHORIZATION TO CONSTRUCT / OPERATION PERMIT / EXISTING SYSTEM INSPECTION

PERMIT# 74097 PIN# 4787 53 8786 DATE 6-20-98

OWNER OR CONTRACTOR Richard Walker PHONE: Business Home 878 9624

ADDRESS 129 Beaverbrook Rd Statesville

LOCATION 64 East To Cool Sp. Rt TR Lasserheat 1/2mi Rt (216 Lasserheat Rd)

SUBDIVISION BLOCK / SECTION LOT LOT AREA 100' x 205 SITE CLASS. PS DESIGN FLOW 360 L.T.A.R. .38

Septic Tank: 1000 Gallons; STB 620 Date 4-24-98

Pump Tank: Gallons; PT Date

Pump Make: Model Serial No.

Nitrification Field: No Fields 1 Square Feet 960 Linear Feet 320

No Lines 4 Trench Width 36" Max Trench Bottom Depth 36" Gravel Depth 12"

☑ New System ☐ Repair System Type: I (II) III, IV, V, VI

System Description: Conv. Gravity

Repair System Description: " "

Maintenance Agreement Required: ☐ Yes ☑ No

☐ House/Mod. Home ☑ Mobile Home ☐ Business ☐ Other

No. Bedrooms 3 No. Bathrooms 2 No. Employees


☐ Slab ☑ Crawl Space ☐ Basement w/plumbing ☐ Basement wo/plumbing

Water Supply: ☑ Individual ☐ Public ☐ Community


Comments:/Conditions:

Comments:/Conditions:

INITIAL SITE SKETCH 205'

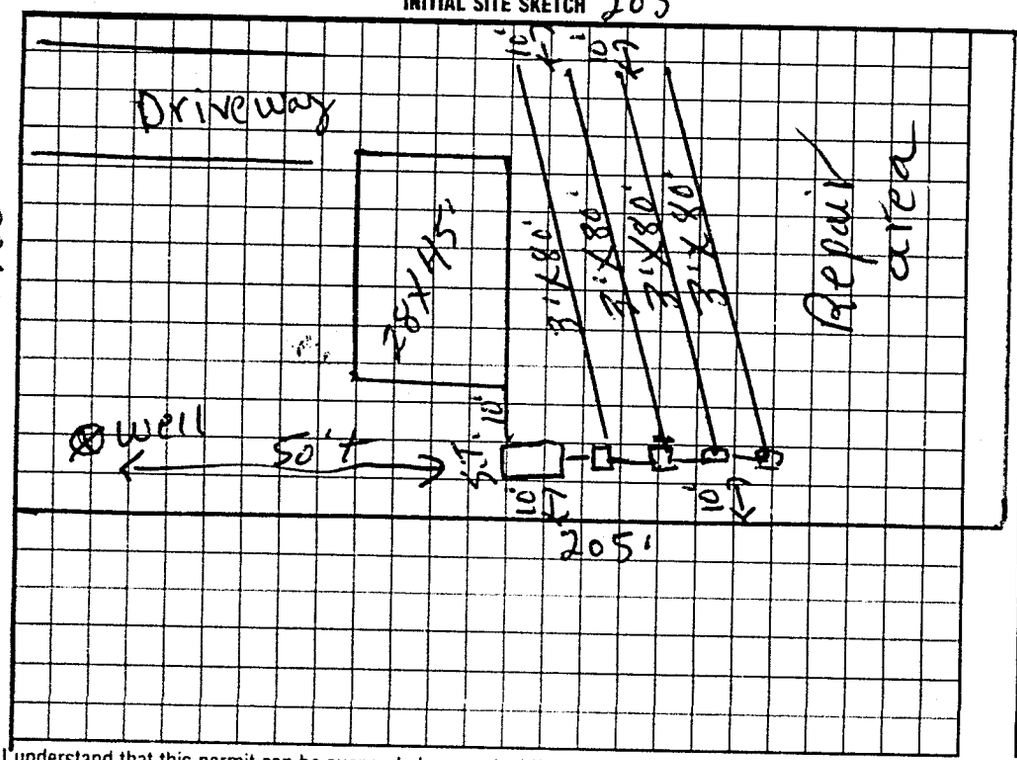

AS BUILT SKETCH

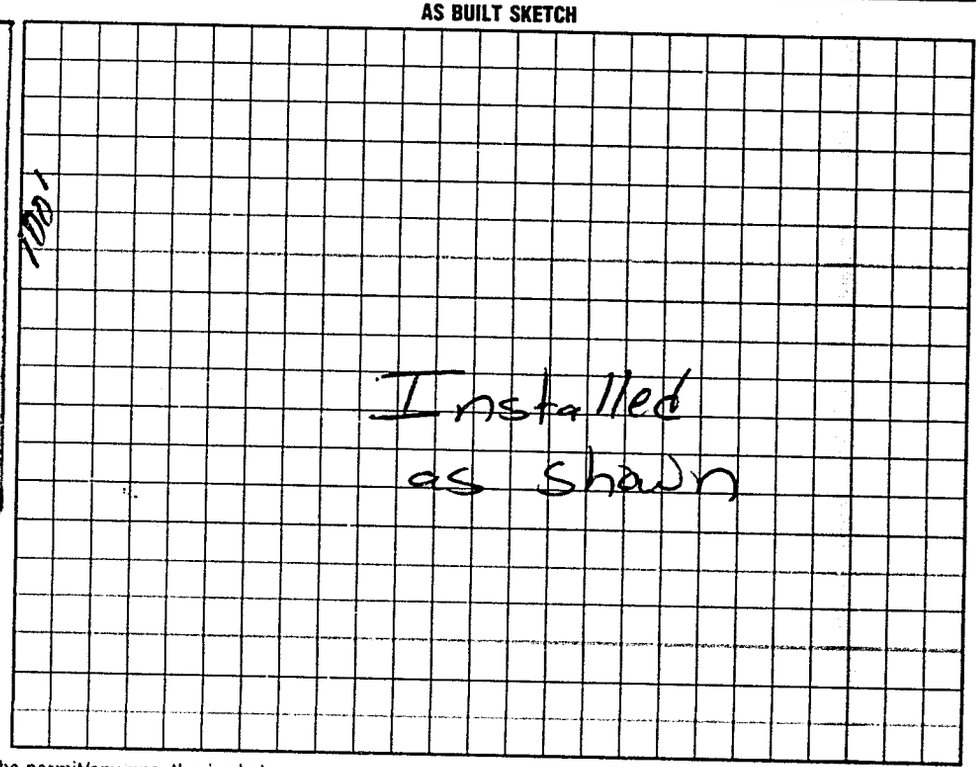

I understand that this permit can be suspended or revoked if any false information is supplied toward securing the permit/any unauthorized changes are made to the site/any unauthorized changes are made in the installation of the system. Improvement Permit with plat valid without expiration. Improvement Permit with site plan valid for sixty months. Authorization to Construct is valid for a period equal to that of Improvement Permit – not to exceed sixty months.

Signed: Richard E. Walker date 6-20-98

Improvement Permit by: E. C. Moore date 6-20-98

Authorization to Construct by: E. C. Moore date 6-20-98

Installed by: Sammy Reavis

Operation Permit by: [illegible] date 7-9-98

Existing System inspection by: date

HEALTH DEPT COPY WHITE INSPECTION COPY (FINAL) GREEN OWNER COPY (FINAL) YELLOW INSPECTION COPY (INITIAL) PINK OWNER COPY (INITIAL) GOLD