I 00 62439

IREDELL COUNTY HEALTH DEPARTMENT

STATESVILLE 704-878-5305 MOORESVILLE 704-664-5281

IMPROVEMENT PERMIT / CERTIFICATE OF COMPLETION / OPERATION PERMIT / EXISTING SYSTEM INSPECTION

PROPERTY DESCRIPTION NO. 24186 DATE 7-13-96 TAX MAP NO. 11K-A-64 Watershed: ☐ Yes ☒ No

OWNER OR CONTRACTOR Kevan + Nina mc Evoy PHONE: Business Home 875-1516

ADDRESS 1310 Hunters Rd Huntersville N.C.

LOCATION 64E TL Cool Sp. Rd TR Edgewood 1st Drive TR 1/8 mi on left

SUBDIVISION BLOCK / SECTION LOT LOT AREA 2.25 acres SITE CLASS. PS DESIGN FLOW 360 L.T.A.R. 1.3

Septic Tank: 1000 Gallons; STB 760 Date 6-9-96

Pump Tank: Gallons; PT Date

Pump Make: Model Serial No.

Nitrification Field: No Fields 1 Square Feet 1200 Linear Feet 400

No Lines 3 Trench Width 36" Max Trench Bottom Depth 24" Gravel Depth 12"

☒ New System ☐ Repair System Type: I / II, III, IV, V, VI

System Description: conv. trench/

Repair System Description:

Maintenance Agreement Required: ☐ Yes ☒ No

☒ House/Mod. Home No. Bedrooms 3

☐ Mobile Home No. Bathrooms 2

☐ Business No. Employees

☐ Other


☐ Slab ☐ Crawl Space ☒ Basement w/plumbing ☐ Basement wo/plumbing

Water Supply: ☒ Individual ☐ Community ☐ Public


Comments:

Comments: over 100' to S.T. ⊗ well site

INITIAL SITE SKETCH

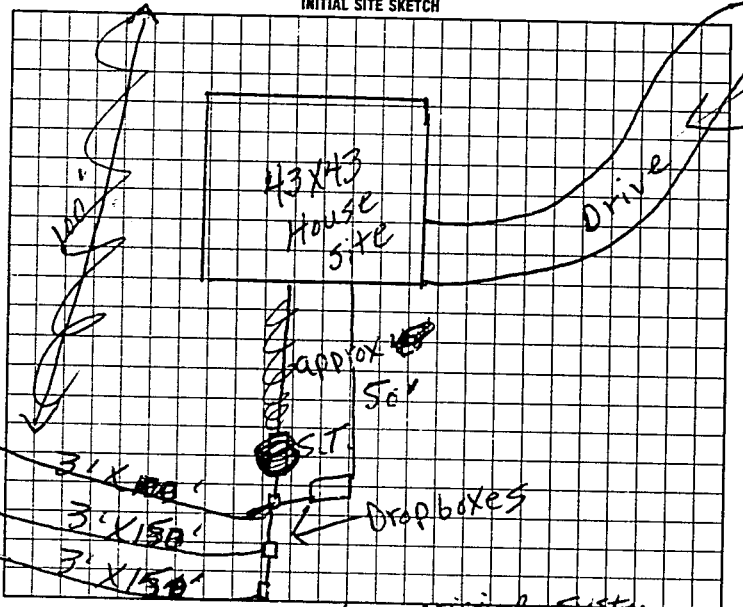

AS BUILT SKETCH

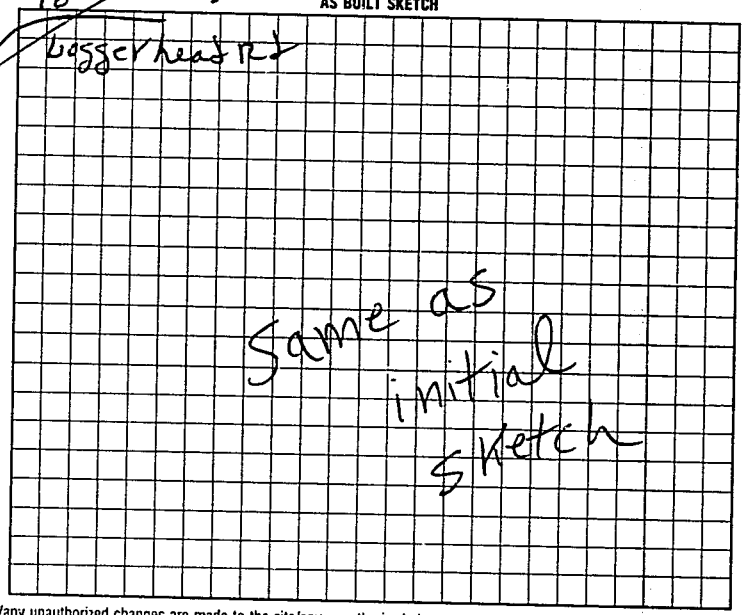

I understand that this permit can be suspended or revoked if any false information is supplied toward securing the permit/any unauthorized changes are made to the site/any unauthorized changes are made in the installation of the system.

Signed: Kevan & Mc Evoy

Improvement Permit by: P.C. moore date 7-13-96

Authorization to construct existing system inspection by: P.C. moore date 7-13-96

Installed by: D.L. Whitaker Grading Davie Co.

Certificate of Completion by: date

Operation Permit by: P.C. moore date 12-23-96

Expires 60 mos from issue

HEALTH DEPT. COPY WHITE INSPECTION COPY (FINAL) GREEN OWNER COPY (FINAL) YELLOW INSPECTION COPY (INITIAL) PINK OWNER COPY (INITIAL) GOLD