(Hitts)

IREDELL COUNTY HEALTH DEPARTMENT

STATESVILLE 704-878-5305 MOORESVILLE 704-664-5281 (ad)

IMPROVEMENT PERMIT / AUTHORIZATION TO CONSTRUCT / OPERATION PERMIT / EXISTING SYSTEM INSPECTION

PERMIT # 15080 PIN # 4787-62 3972 DATE 6-23-09

OWNER or APPLICANT Hitts Vending PHONE: Business Home: 704-437-6250

OWNER or APPLICANT ADDRESS 146 Durand Lane

LOCATION / DIRECTIONS 64 to CR 1001 Spring (R) Pasquhead (R) Durand on right

SUBDIVISION Campbell Estates BLOCK / SECTION LOT # 18 LOT AREA .79 DESIGN FLOW 360 L.T.A.R. Excl.

Septic Tank 1000 Gallons: STB 928 Date 4-10-95

Pump Tank Gallons: P T Date

Pump Make Model Serial #

Nitrification Field No Fields No Lines Linear Feet 345 est

Trench Width 36" Max. Trench Bottom Depth 34 Gravel Depth 12

☐ New System ☐ Repair ☐ Expansion System Type I II III IV V VI

System Description: Gravel Conventional

Repair System Description: 250 Gravel / pump

Maintenance Agreement Required ☐ YES ☑ NO

☑ GRAVITY ☐ PRESSURE

☐ Residence No. Bedrooms 3

☐ Business No. Persons

☐ Other No. Employees

☐ Slab ☑ Crawl Space


☐ Basement w/plumbing ☐ Basement w/o plumbing

Water Supply: ☐ Private ☐ Public ☐ Community


Comments / Conditions

Comments / Conditions

INITIAL SITE SKETCH

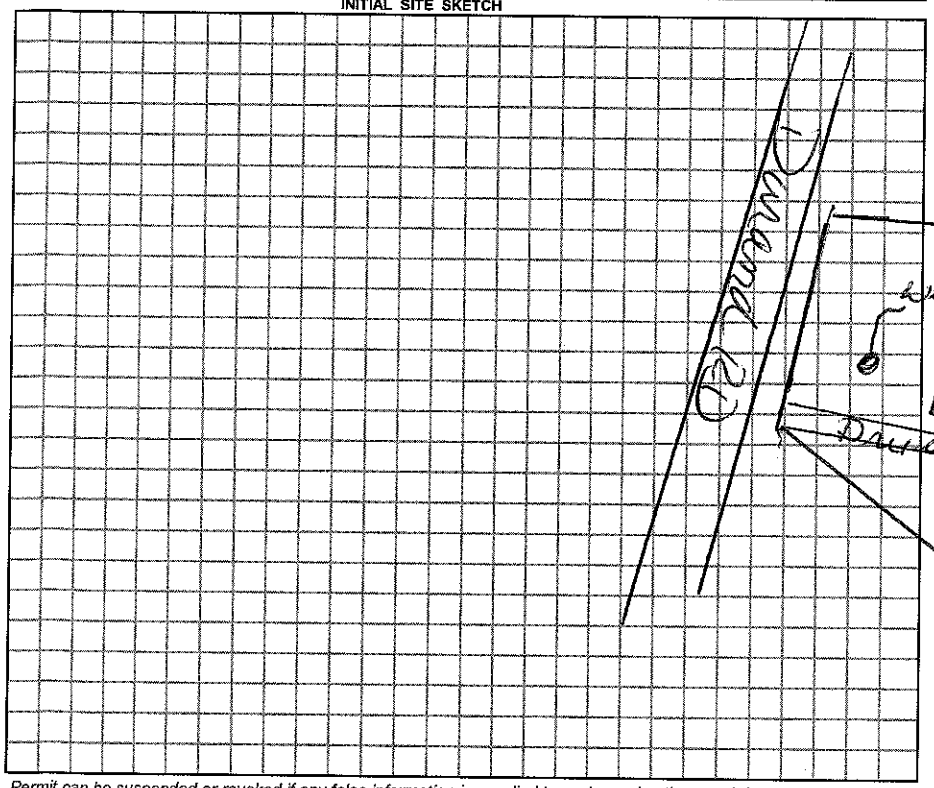

AS BUILT SKETCH

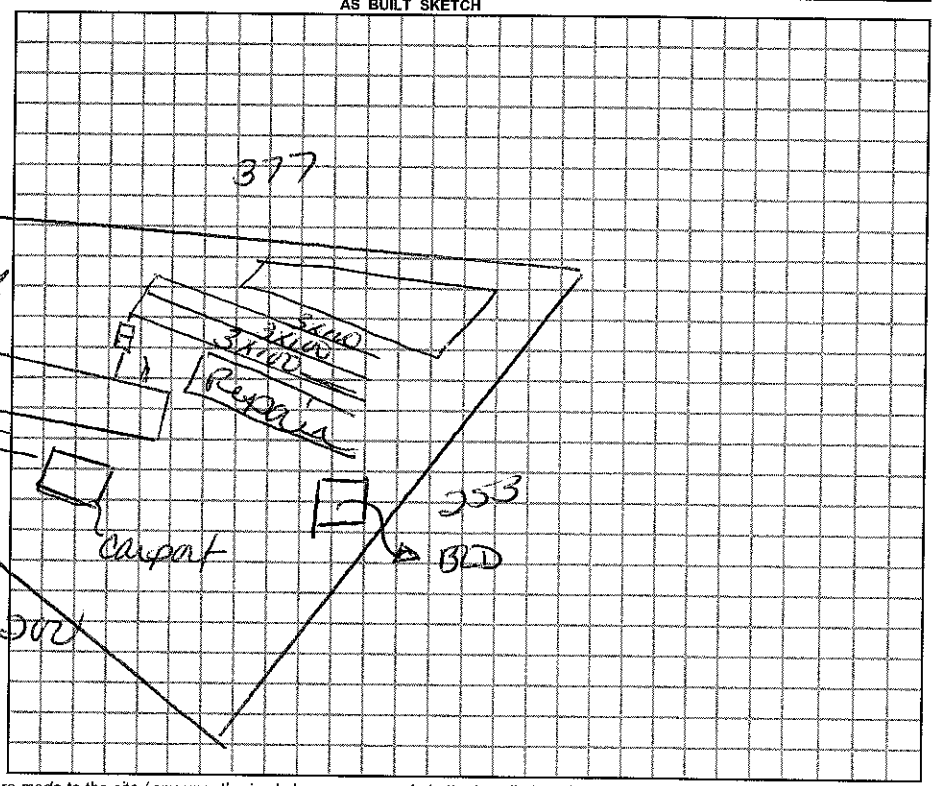

Permit can be suspended or revoked if any false information is supplied toward securing the permit / any unauthorized changes are made to the site / any unauthorized changes are made in the installation of the system.

☐ *IMPROVEMENT PERMIT w / plat valid without expiration.* ☐ *IMPROVEMENT PERMIT w / site plan valid for 60 mos.* ☑ *AUTHORIZATION TO CONSTRUCT valid for period equal to IMPROVEMENT PERMIT-not to exceed 60 mo.*

Owner / Applicant Signature: Date

Improvement Permit by: Date

Authorzation to Construct by: Date

YOU SHOULD CONTACT A LOCATOR SERVICE PRIOR TO ANY EXCAVATION.

Installed by:

Operation Permit by: Date:

Existing System Inspected by: Kelly Cook Date: 6-23-09

WHITE COPY Environmental Health / YELLOW COPY (Final) Owner / Applicant / PINK COPY (Initial) Owner / Applicant