IREDELL COUNTY HEALTH DEPARTMENT

STATESVILLE 704-878-5305 MOORESVILLE 704-664-5281

IMPROVEMENT PERMIT / CERTIFICATE OF COMPLETION / OPERATION PERMIT / EXISTING SYSTEM INSPECTION

PROPERTY DESCRIPTION NO. 21288 DATE 6-7-95 TAX MAP NO. 11K-2-A-18 Watershed: ☐ Yes ☑ No

OWNER OR CONTRACTOR John L. Irby PHONE: Business _____ Home 546-5565

ADDRESS 420 Chief Thomas Rd

LOCATION 64E To Cool Spring Rd TR Lossenhut TR Durand 1/4mi Rt

SUBDIVISION Campbell's BLOCK / SECTION _____ LOT 18 LOT AREA .789 acres SITE CLASS. P3 DESIGN FLOW 360 L.T.A.R. .35

Septic Tank: 1000 Gallons; STB 928 Date 4-10-95

Pump Tank: _____ Gallons; PT _____ Date _____

Pump Make _____ Model _____ Serial No. _____

Nitrification Field: No Fields 1 Square Feet 1035 Linear Feet 345

No Lines 3 Trench Width 36" Max Trench Bottom Depth 36" Gravel Depth 12"

☑ New System ☐ Repair System Type: I, II, III, IV, V, VI

System Description: Conv. Gravity

Repair System Description: " "

Maintenance Agreement Required: ☐ Yes ☑ No

☐ House/Mod. Home No. Bedrooms 3

☑ Mobile Home No. Bathrooms 2

☐ Business No. Employees _____

☐ Other _____


☐ Slab ☑ Crawl Space ☐ Basement w/plumbing ☐ Basement wo/plumbing

Water Supply: ☑ Individual ☐ Community ☐ Public

Comments:

Comments: Well & mobile Home not on site at time of this inspection Keep proper distances from S.T. system

INITIAL SITE SKETCH

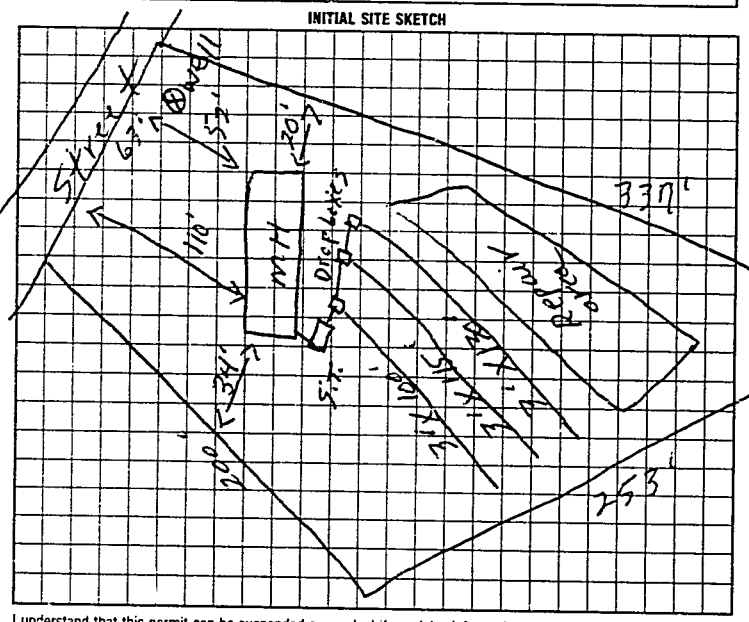

AS BUILT SKETCH

Same as initial sketch

I understand that this permit can be suspended or revoked if any false information is supplied toward securing the permit/any unauthorized changes are made to the site/any unauthorized changes are made in the installation of the system. Improvement Permit is valid for 60 months from date of issuance.

Signed: X John L. Irby

Improvement Permit by: L. C. Moore date 6-7-95

Existing System Inspection by: _____ date _____

Installed by: Sammy Reavis

Certificate of Completion by: L. C. Moore date 6-23-95

Operation Permit by: _____ date _____

HEALTH DEPT. COPY: WHITE INSPECTION COPY (FINAL): GREEN OWNER COPY (FINAL): YELLOW INSPECTION COPY (INITIAL): PINK OWNER COPY (INITIAL): GOLD