IREDELL COUNTY HEALTH DEPARTMENT

STATESVILLE 704-878-5305 MOORESVILLE 704-664-5281

IMPROVEMENT PERMIT / CERTIFICATE OF COMPLETION / OPERATION PERMIT / EXISTING SYSTEM INSPECTION

09163

PROPERTY DESCRIPTION NO. 25412 DATE 11-4-96 TAX MAP NO. 11K-2-A-21 Watershed: ☐ Yes ☐ No

OWNER OR CONTRACTOR Curtis Plemons PHONE: Business ~~Home~~ 873-1481

ADDRESS c/o 2014 Northside Dr.

LOCATION US 64E TL Cooksp Rd TR Hesserhead TR Durant Next to last lot Rt.

SUBDIVISION Campbell Est. BLOCK / SECTION LOT 21 LOT AREA 3/4 acre SITE CLASS. PS DESIGN FLOW 240 L.T.A.R. .13

Septic Tank: 1000 Gallons; STB 1012 Date 8-10-96

Pump Tank: Gallons; PT Date

Pump Make: Model Serial No.

Nitrification Field: No Fields 1 Square Feet 810 Linear Feet 270

No Lines 2 Trench Width 36" Max Trench Bottom Depth 36" Gravel Depth 12"

☑ New System ☐ Repair System Type: I, II, III, IV, V, VI

System Description: Conv. Gravity

Repair System Description:

Maintenance Agreement Required: ☐ Yes ☐ No

☐ House/Mod. Home ☑ Mobile Home ☐ Business ☐ Other

No. Bedrooms 2 No. Bathrooms 2 No. Employees


☐ Slab ☐ Crawl Space ☐ Basement w/plumbing ☐ Basement wo/plumbing

Water Supply: ☑ Individual ☐ Community ☐ Public

Comments:

Comments:

INITIAL SITE SKETCH

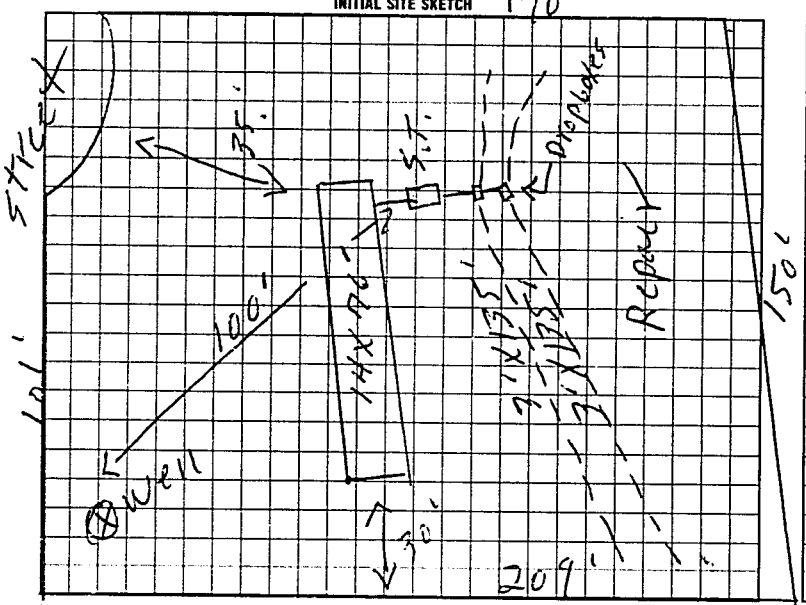

AS BUILT SKETCH

Same as initial sketch

I understand that this permit can be suspended or revoked if any false information is supplied toward securing the permit/any unauthorized changes are made to the site/any unauthorized changes are made in the installation of the system.

Signed: Eric N. Hall

Improvement Permit by: R. C. Moore date 11-4-96

Authorization to Construct by: R. C. Moore date 11-4-96

Installed by: A-1 Backhoe

Certificate of Completion by: date

Operation Permit by R. C. Moore date 11-15-0

HEALTH DEPT. COPY: WHITE INSPECTION COPY (FINAL): GREEN OWNER COPY (FINAL): YELLOW INSPECTION COPY (INITIAL): PINK OWNER COPY (INITIAL): GOLD

+0 cons. Authorization to Const. Expires 60 mos from 1st

Z 8 8 1 0 0