IREDELL COUNTY HEALTH DEPARTMENT

STATESVILLE 704-878-5305 MOORESVILLE 704-664-5281

IMPROVEMENT PERMIT / CERTIFICATE OF COMPLETION / OPERATION PERMIT / EXISTING SYSTEM INSPECTION

PROPERTY DESCRIPTION NO. 25404 DATE 11-6-96 TAX MAP NO. 11k 3-A 15 Watershed: [ ] Yes [X] No

OWNER OR CONTRACTOR Fil Pishner PHONE: Business Home 873-7130

ADDRESS 136 Horizon Drive Statesville NC.

LOCATION 64E to Coolsprings rd TR 1st crossroad TR Horizon Drive 800ft on left

SUBDIVISION Sunset Village BLOCK / SECTION LOT 15 LOT AREA SITE CLASS P/S DESIGN FLOW 360 L.T.A.R. 0.35

Septic Tank: 1000 Gallons; STB 620 Date 6-15-97

Pump Tank: Gallons; PT Date

Pump Make: Model Serial No.

Nitrification Field: No Fields Square Feet 1028 Linear Feet 343

No Lines 4 Trench Width 36 Max Trench Bottom Depth 36

[X] New System [ ] Repair System Type: I, [II] III, IV, V, VI

System Description: Gravity Conventional

Repair System Description: Gravity Conventional

Maintenance Agreement Required: [ ] Yes [X] No Chamber

[ ] House/Mod. Home [X] Mobile Home [ ] Business [ ] Other

No. Bedrooms 3 No. Bathrooms 2 No. Employees


[ ] Slab [X] Crawl Space [ ] Basement w/plumbing [ ] Basement wo/plumbing

Water Supply: [X] Individual [ ] Community [ ] Public


Comments: keep lines 9ft from center, keep wells 100 ft from systems

Comments:

INITIAL SITE SKETCH

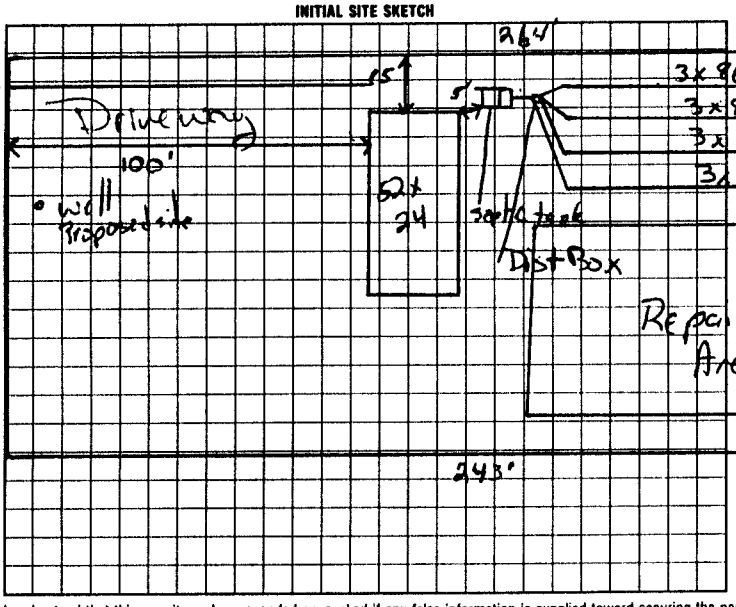

AS BUILT SKETCH

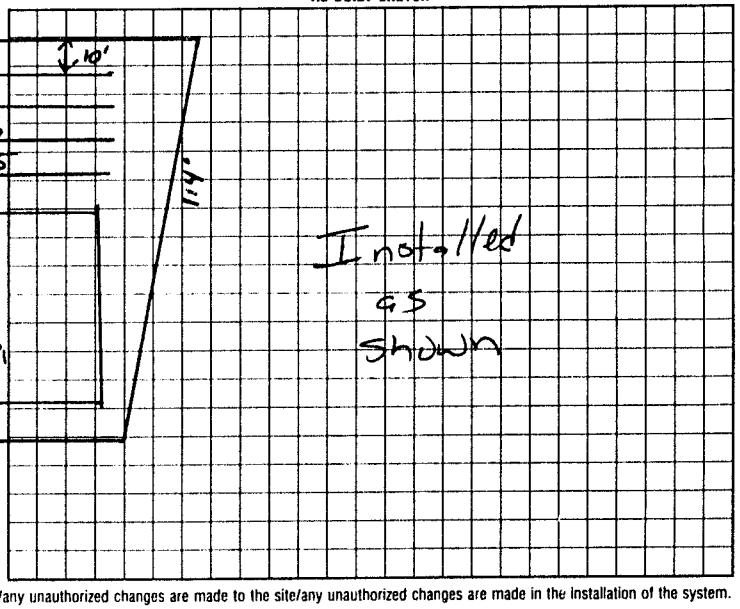

I understand that this permit can be suspended or revoked if any false information is supplied toward securing the permit/any unauthorized changes are made to the site/any unauthorized changes are made in the installation of the system.

Authorization to Const. expires 5yrs after issue date

Signed: [X] Fil Pishner

Improvement Permit by: Mark C Cox RS date 11-6-96

Existing System Inspection by: Mark C Cox RS date 11-6-96

Installed by: Sammy Reavis

Certificate of Completion by: date

Operation Permit by: Mark C Cox RS date 8-28-97

HEALTH DEPT. COPY: WHITE INSPECTION COPY (FINAL): GREEN OWNER COPY (FINAL): YELLOW INSPECTION COPY (INITIAL): PINK OWNER COPY (INITIAL): GOLD