IREDELL COUNTY HEALTH DEPARTMENT

STATESVILLE 704-878-5305 MOORESVILLE 704-664-5281

IMPROVEMENT PERMIT / CERTIFICATE OF COMPLETION / OPERATION PERMIT / EXISTING SYSTEM INSPECTION

PROPERTY DESCRIPTION NO. 25403 DATE 11-6-96 TAX MAP NO. 11K -3A-16

OWNER OR CONTRACTOR Fil Fishner PHONE: Business _____ Home 873 7130 Watershed: ☐ Yes ☒ No

ADDRESS 136 Horizon Dr Statesville NC

LOCATION 64E TL Cool Springs Rd TR Logger Head Rd TR Horizon 700ft on RT

SUBDIVISION Sunset Village BLOCK / SECTION _____ LOT 16 LOT AREA _____ SITE CLASS. F/S DESIGN FLOW 360 L.T.A.R. 0.35

Septic Tank: 1000 Gallons; STB 600 Date 7-8-97

Pump Tank: _____ Gallons; PT _____ Date 5-27-97

Pump Make: _____ Model _____ Serial No. _____

Nitrification Field: No Fields 1 Square Feet 1028 Linear Feet 343

No Lines 3 Trench Width 36 Max Trench Bottom Depth 36 Gravel Depth 12

☒ New System ☐ Repair System Type: I, II, III, IV, V, VI

System Description: Gravity Conventional

Repair System Description: Gravity Conventional

Maintenance Agreement Required: ☐ Yes ☒ No Chambers

☐ Slab ☒ Crawl Space ☐ Basement w/plumbing ☐ Basement wo/plumbing

☐ House/Mod. Home No. Bedrooms 3

☒ Mobile Home No. Bathrooms 2

☐ Business No. Employees _____


☐ Other _____

Water Supply: ☒ Individual ☐ Community ☐ Public


Comments: Keep lines on contour, 9ft on center wells 100ft from systems

Comments:

INITIAL SITE SKETCH

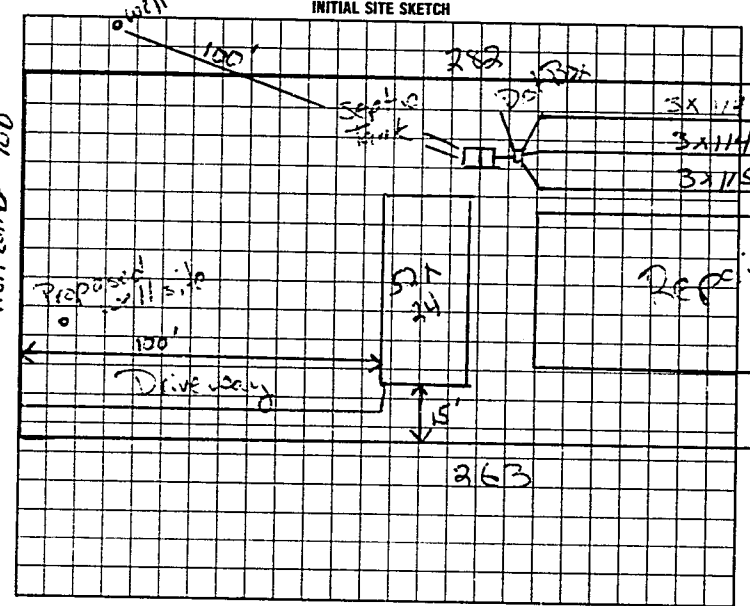

AS BUILT SKETCH

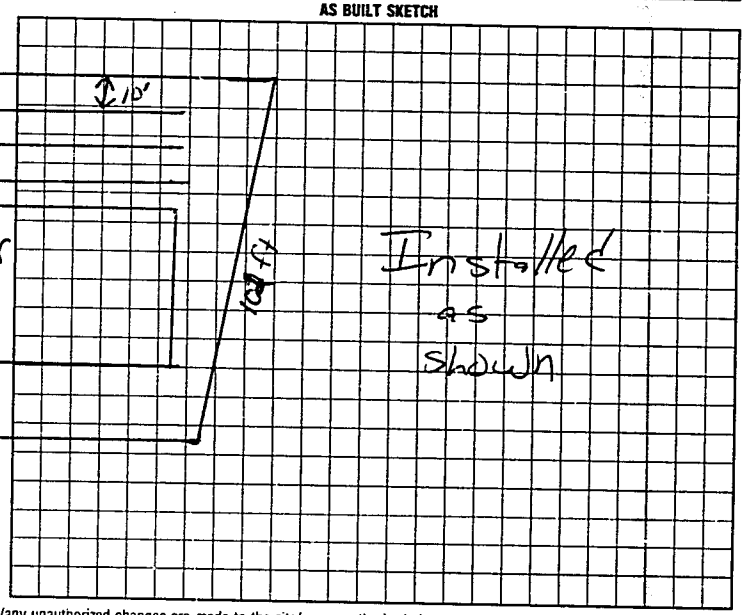

I understand that this permit can be suspended or revoked if any false information is supplied toward securing the permit/any unauthorized changes are made to the site/any unauthorized changes are made in the installation of the system.

Authorization to construct expires 5 yrs after issue date.

Signed: X Fil Fishner

Improvement Permit by: Mark Cole RS date 11-6-96

Authorization to construct

Existing System Inspection by: Mark Cole RS date 11-6-96

Installed by: Sammy Reavis

Certificate of Completion by: _____ date _____

Operation Permit by: Mark Cole RS date 8-28-97

HEALTH DEPT. COPY: WHITE INSPECTION COPY (FINAL): GREEN OWNER COPY (FINAL): YELLOW INSPECTION COPY (INITIAL): PINK OWNER COPY (INITIAL): GOLD