IREDELL COUNTY HEALTH DEPARTMENT

50982 ~~5892~~

STATESVILLE 704-878-5305 MOORESVILLE 704-664-5281

IMPROVEMENT PERMIT / CERTIFICATE OF COMPLETION / OPERATION PERMIT / EXISTING SYSTEM INSPECTION

PROPERTY DESCRIPTION NO. 18000 DATE 4-14-94 TAX MAP NO. 11K-A-18A Watershed: ☐ Yes ☐ No

OWNER OR CONTRACTOR Lynn Barker PHONE: Business Home 871-1438

ADDRESS Rt 9 Box 232 A Statesville, N.C.

LOCATION Cool Spring Rd Turn on Bosser Heat TR Durand Dr. 1st lot on Rt

SUBDIVISION Campbell Est BLOCK / SECTION LOT 3 LOT AREA 88,427 acres SITE CLASS. PS DESIGN FLOW L.T.A.R.

Septic Tank: 1000 Gallons; STB 794 Date 2-16-94

Pump Tank: Gallons; PT Date

Pump Make: Model Serial No.

Nitrification Field: No Fields 1 Square Feet 1035 Linear Feet 345

No Lines 3 Trench Width 36" Max Trench Bottom Depth 36" Gravel Depth 12"

☑ New System ☐ Repair System Type: I, ☑ II, III, IV, V, VI

System Description: Conv. Gravity

Repair System Description: " "

Maintenance Agreement Required: ☐ Yes ☑ No

☐ House/Mod. Home ☑ Mobile Home ☐ Business ☐ Other

No. Bedrooms 3 No. Bathrooms 2 No. Employees


☐ Slab ☑ Crawl Space ☐ Basement w/plumbing ☐ Basement wo/plumbing

Water Supply: ☑ Individual ☐ Community ☐ Public

Comments:

Comments:

INITIAL SITE SKETCH

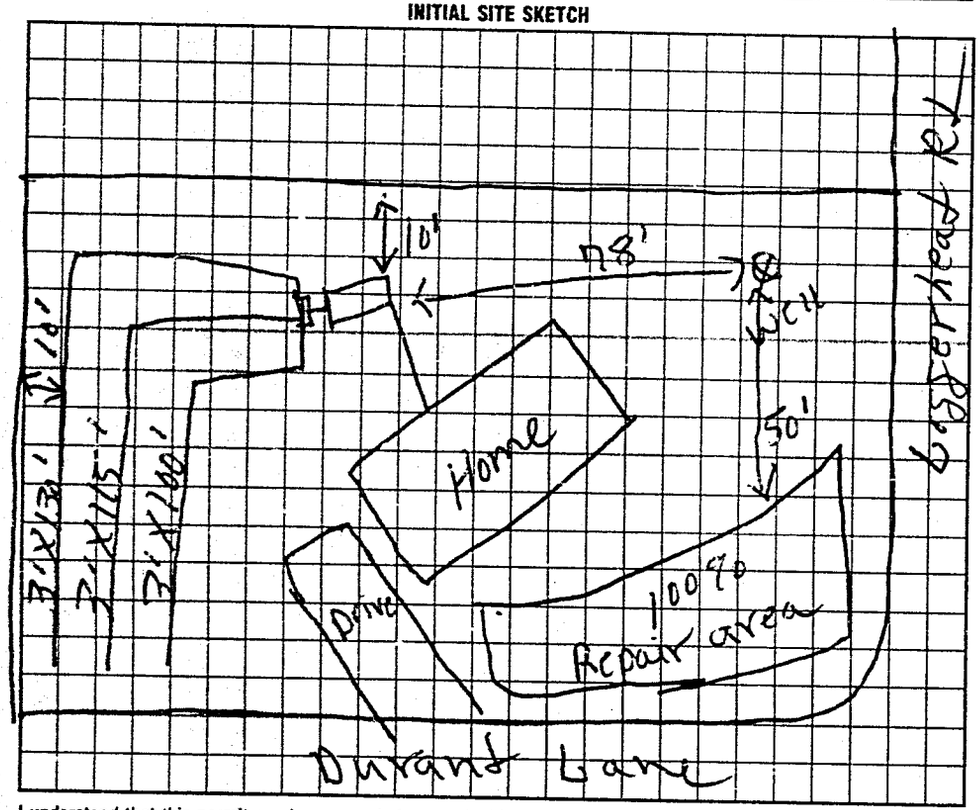

AS BUILT SKETCH

Same as initial Sketch

I understand that this permit can be suspended or revoked if any false information is supplied toward securing the permit/any unauthorized changes are made to the site/any unauthorized changes are made in the installation of the system. Improvement Permit is valid for 60 months from date of issuance.

Signed: X L. Lynn Barker

Improvement Permit by: J. C. Moore date 4-14-94

Existing System Inspection by: date

Installed by: A-1 Backhoe

Certificate of Completion by: J. C. Moore date 4-27-94

Operation Permit by: date

HEALTH DEPT. COPY: WHITE INSPECTION COPY (FINAL): GREEN OWNER COPY (FINAL): YELLOW INSPECTION COPY (INITIAL): PINK OWNER COPY (INITIAL): GOLD