619977

IREDELL COUNTY HEALTH DEPARTMENT

STATESVILLE 704-878-5305 MOORESVILLE 704-664-5281

IMPROVEMENT PERMIT / CERTIFICATE OF COMPLETION / OPERATION PERMIT / EXISTING SYSTEM INSPECTION

PROPERTY DESCRIPTION NO. 24231 DATE 7-17-96 TAX MAP NO. 11K-3- A-14 Watershed: ☐ Yes ☐ No

OWNER OR CONTRACTOR Olde Towne Mobile PHONE: Business 873-1481 Home

ADDRESS 2016 Northside Dr. Statesville

LOCATION 64E TL coolSp Rd TR Fesserhead TR Horizon Dr. 1st left

SUBDIVISION Sunset Village BLOCK / SECTION LOT 14 LOT AREA .64 Acres SITE CLASS PS DESIGN FLOW 360 L.T.A.R. .3

Septic Tank: 1000 Gallons; STB Date

Pump Tank: Gallons; PT Date

Pump Make: Model Serial No.

Nitrification Field: No Fields 1 Square Feet 1200 Linear Feet 400

No Lines 5 Trench Width 36" Max Trench Bottom Depth 36" Gravel Depth 12"

☑ New System ☐ Repair System Type: I, II, III, IV, V, VI

System Description: Conv. Gravity

Repair System Description: Gravity Chambers

Maintenance Agreement Required: ☐ Yes ☑ No

☐ House/Mod. Home ☐ Mobile Home ☐ Business ☐ Other

No. Bedrooms 3 No. Bathrooms 2 No. Employees


☐ Slab ☐ Crawl Space ☐ Basement w/plumbing ☐ Basement wo/plumbing

Water Supply: ☐ Individual ☐ Community ☐ Public


Comments:

Comments:

INITIAL SITE SKETCH

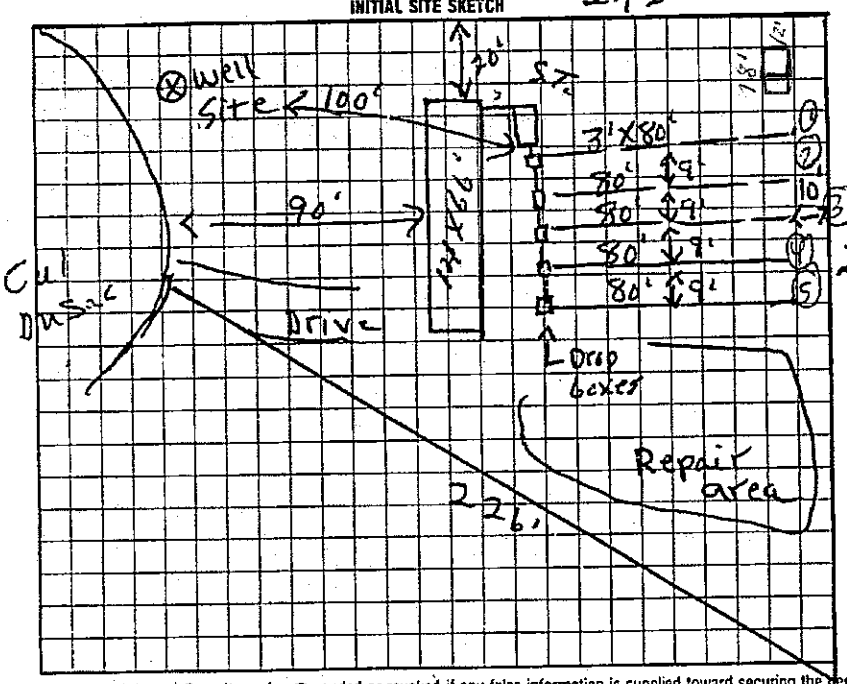

AS BUILT SKETCH

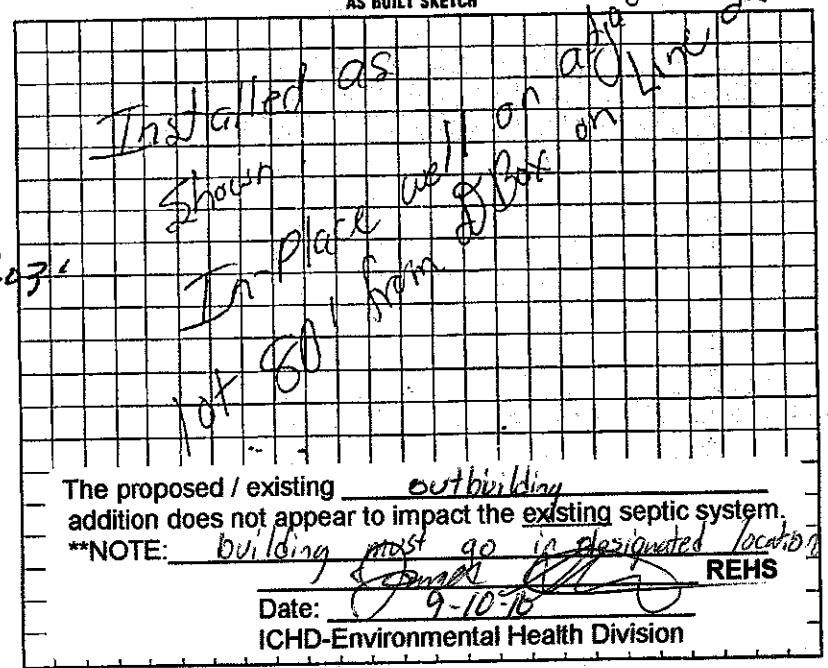

The proposed / existing outbuilding addition does not appear to impact the existing septic system.

**NOTE: building must go in designated location

REHS


ICHD-Environmental Health Division

I understand that this permit can be suspended or revoked if any false information is supplied toward securing the permit/any unauthorized changes are made to the site/any unauthorized changes are made in the installation of the system.

Signed: Lori Owen

Improvement Permit by: L.C. moore date 7-17-96

Existing System Inspection by: authorization to collect L.C. moore date 7-17-96

Installed by: A1 Backhoe

Certificate of Completion by: date

Operation Permit by: date 8/28/96

HEALTH DEPT. COPY: WHITE INSPECTION COPY (FINAL): GREEN OWNER COPY (FINAL): YELLOW INSPECTION COPY (INITIAL): PINK OWNER COPY (INITIAL): GOLD

authorization to const. Expires 60 mos from issue

S 1 7 1 0 0