IREDELL COUNTY HEALTH DEPARTMENT

STATESVILLE 704-878-5305 MOORESVILLE 704-664-5281

IMPROVEMENT PERMIT / CERTIFICATE OF COMPLETION / OPERATION PERMIT / EXISTING SYSTEM INSPECTION

PROPERTY DESCRIPTION NO. 19618 DATE 11-9-94 TAX MAP NO. 11K-2-A-15 Watershed: ☐ Yes ☐ No

OWNER OR CONTRACTOR Zandle Kinder PHONE: Business Home 838-1736

ADDRESS 151 Village Dr. Statesville, N.C.

LOCATION 642 To Cool Springs R to TR to second TR Durant Zone 1/8 mi RT

SUBDIVISION Campbell Est. BLOCK / SECTION LOT 15 LOT AREA 1.6 acres SITE CLASS. PS DESIGN FLOW 360 L.T.A.R. 89.4

Septic Tank: 1000 Gallons; STB 10/2 Date 9-6-94

Pump Tank: Gallons; PT Date

Pump Make: Model Serial No.

Nitrification Field: No Fields 1 Square Feet 900 Linear Feet 300

No Lines 3 Trench Width 36" Max Trench Bottom Depth 36" Gravel Depth 12"

☑ New System ☐ Repair System Type: I, II, III, IV, V, VI

System Description: Conv. Gravity

Repair System Description: " "

Maintenance Agreement Required: ☐ Yes ☑ No

☐ Mobile/Mod. Home ☑ Site Built ☑ Mobile Home ☐ Business ☐ Other

No. Bedrooms 3 No. Bathrooms 2 No. Employees


☐ Slab ☑ Crawl Space ☐ Basement w/plumbing ☐ Basement wo/plumbing

Water Supply: ☑ Individual ☐ Community ☐ Public

Comments:

Comments:

INITIAL SITE SKETCH

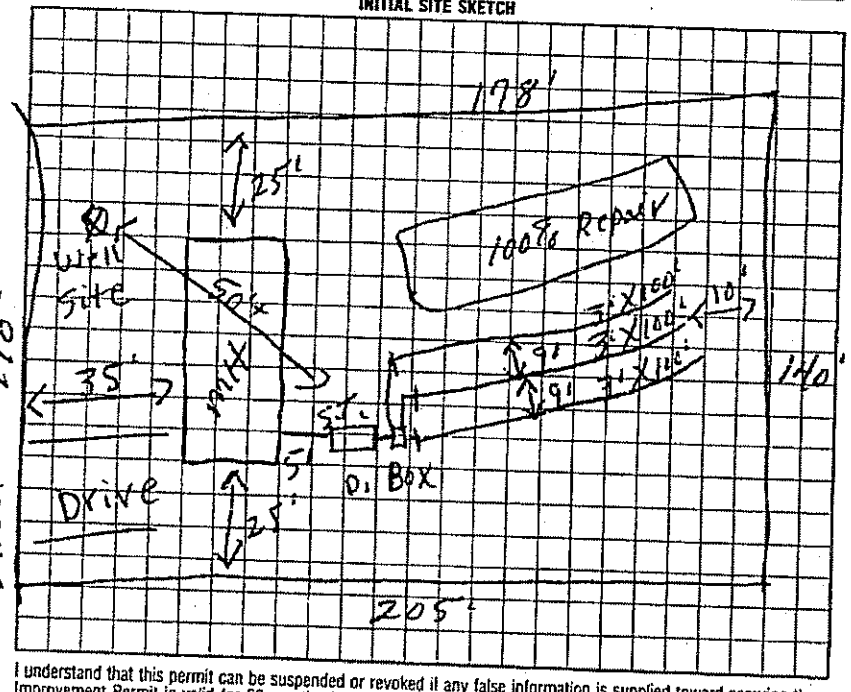

AS BUILT SKETCH

SYSTEM INSTALLED ACCORDING TO INITIAL SITE SKETCH

I understand that this permit can be suspended or revoked if any false information is supplied toward securing the permit/any unauthorized changes are made to the site/any unauthorized changes are made in the installation of the system. Improvement Permit is valid for 60 months from date of issuance.

Signed: Zandle Kinder

Improvement Permit by: R.C. Moore date 11-9-94

Existing System Inspection by: date

Installed by: A-1 BACKHOE

Certificate of Completion by: date

Operation Permit by: STEVE HEARICK date 6-19-96

HEALTH DEPT COPY WHITE INSPECTION COPY (INITIAL) PINK OWNER COPY (INITIAL) GOLD INSPECTION COPY (FINAL) GREEN OWNER COPY (FINAL) YELLOW

00112