IREDELL COUNTY HEALTH DEPARTMENT

STATESVILLE 704-878-5305 MOORESVILLE 704-664-5281

IMPROVEMENT PERMIT / CERTIFICATE OF COMPLETION / OPERATION PERMIT / EXISTING SYSTEM INSPECTION

PROPERTY DESCRIPTION NO. 69541 DATE 10-1-97 TAX MAP NO. 4787631356 Watershed: ☑ Yes ☐ No

OWNER OR CONTRACTOR Rodney A Gootkin PHONE: Business Home

ADDRESS 208 Linburn St.

LOCATION 64E to Cook St. Rt 5 to NC Rt Lazerhurst TR Durant Ln 1/8mi Rt

SUBDIVISION Campbell Est. BLOCK / SECTION LOT 14 LOT AREA 1.55 acres SITE CLASS. PS DESIGN FLOW 360 L.T.A.R. 337

Septic Tank: 1000 Gallons; STB 827 Date 5-23-97

Pump Tank: Gallons; PT Date

Pump Make: Model Serial No.

Nitrification Field: No Fields 1 Square Feet 960 Linear Feet 320

No Lines 4 Trench Width 36" Max Trench Bottom Depth 36" Gravel Depth 12"

☐ New System ☐ Repair System Type: I ☑ II, IV, V, VI

System Description: Conv. Gravity

Repair System Description: Gravity Chamber

Maintenance Agreement Required: ☑ Yes ☐ No

☐ House/Mod. Home No. Bedrooms 3

☑ Mobile Home No. Bathrooms 2

☐ Business No. Employees

☐ Other

☐ Slab ☑ Crawl Space ☐ Basement w/plumbing ☐ Basement wo/plumbing


Water Supply: ☑ Individual ☐ Community ☐ Public

Comments:


Comments:

* House set back ~ 20ft+ from Tank

INITIAL SITE SKETCH

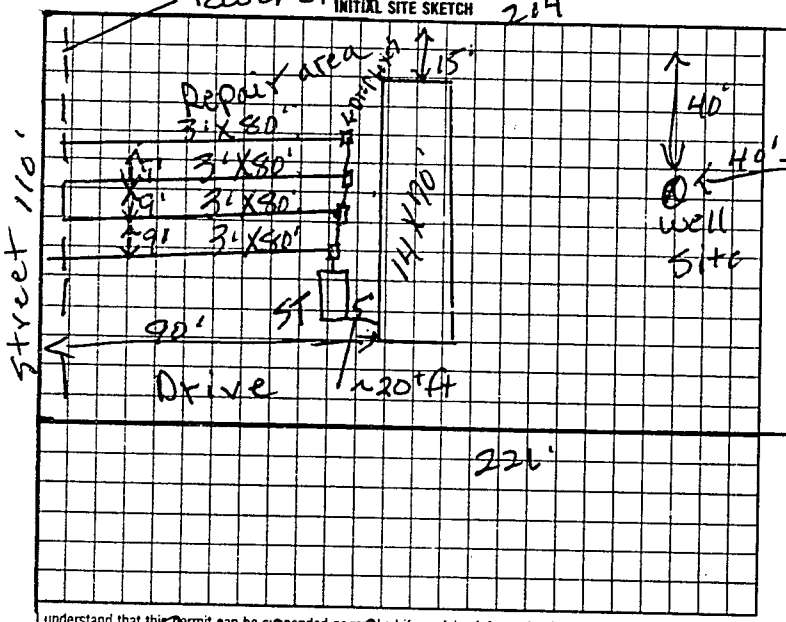

AS BUILT SKETCH

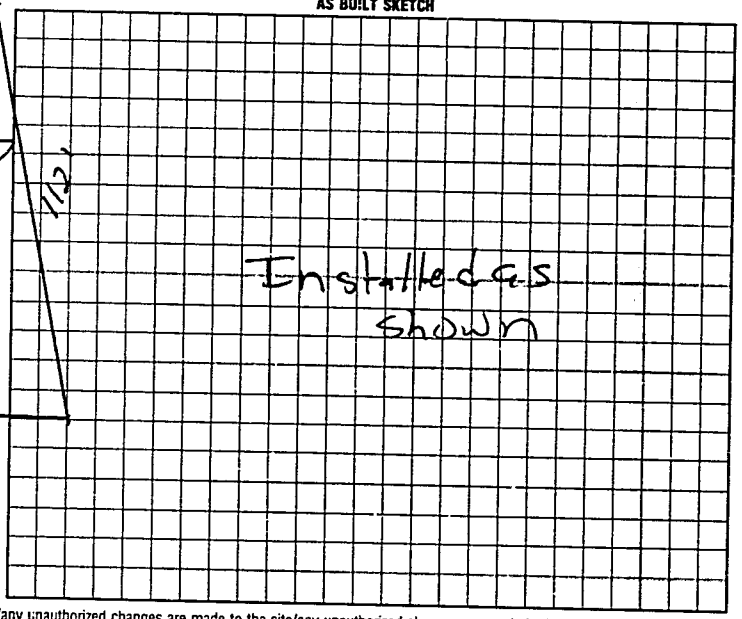

I understand that this permit can be suspended or revoked if any false information is supplied toward securing the permit/any unauthorized changes are made to the site/any unauthorized changes are made in the installation of the system. Improvement Permit is valid for 60 months from date of issuance.

Signed: X Rodney Gootkin

Improvement Permit by: L.C. Moore date 10-1-97

Authorization to Existing System Inspection by: L.C. Moore date 10-1-97

Authorization to Court: Authorization to Court Expires 60 hours from issue

Installed by: Sammy Reavis

Certificate of Completion by: date

Operation Permit by: Mark C. Outlaw date 12-19-97

HEALTH DEPT. COPY: WHITE INSPECTION COPY (FINAL): GREEN OWNER COPY (FINAL): YELLOW INSPECTION COPY (INITIAL): PINK OWNER COPY (INITIAL): GOLD