IREDELL COUNTY HEALTH DEPARTMENT

STATESVILLE 704-878-5305 MOORESVILLE 704-664-5281

50967

IMPROVEMENT PERMIT / CERTIFICATE OF COMPLETION / OPERATION PERMIT / EXISTING SYSTEM INSPECTION

PROPERTY DESCRIPTION NO. 17999 DATE 3-14-94 TAX MAP NO. 11K-A-18A

OWNER OR CONTRACTOR Jeff Brinager PHONE: Business Watershed: ☐ Yes ☒ No

ADDRESS Rt 4 Box 2052-76 Sta Home 878-8610

LOCATION Cool Springs Rd Turn on Logger Head TR New Street (Durand Lane)

SUBDIVISION Campbell Est. BLOCK / SECTION LOT 13 LOT AREA 16 acres SITE CLASS. PS DESIGN FLOW 360 L.T.A.R. .4

Septic Tank: 1000 Gallons: STB 358 Date 3-16-94

Pump Tank: Gallons: PT Date

Pump Make: Model Serial No.

Nitrification Field: No Fields 1 Square Feet 900 Linear Feet 300

No Lines 4 Trench Width 36" Max Trench Bottom Depth 36" Gravel Depth 12"

☒ New System ☐ Repair System Type: I, II, III, IV, V, VI

System Description: Conv. Gravity

Repair System Description: " "

Maintenance Agreement Required: ☐ Yes ☒ No

☐ House/Mod. Home ☒ Mobile Home ☐ Business ☐ Other

No. Bedrooms 3 No. Bathrooms 2 No. Employees


☐ Slab ☒ Crawl Space ☐ Basement w/plumbing ☐ Basement wo/plumbing

Water Supply: ☒ Individual ☐ Community ☐ Public


Comments:

Comments:

INITIAL SITE SKETCH

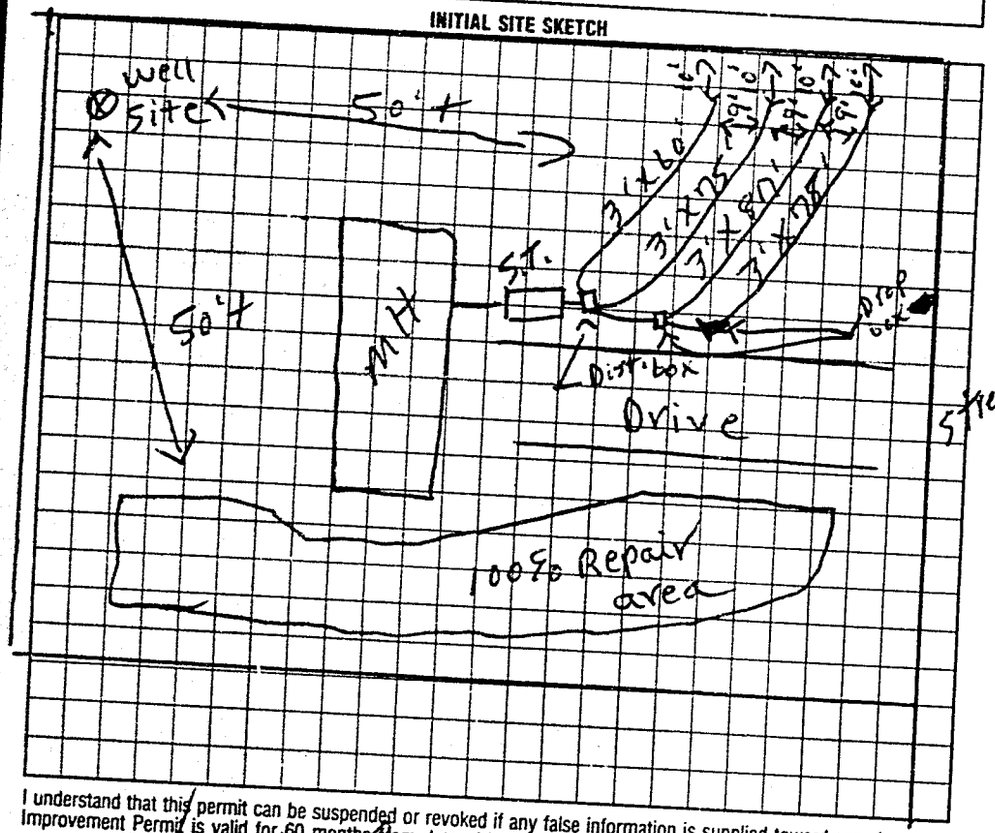

AS BUILT SKETCH

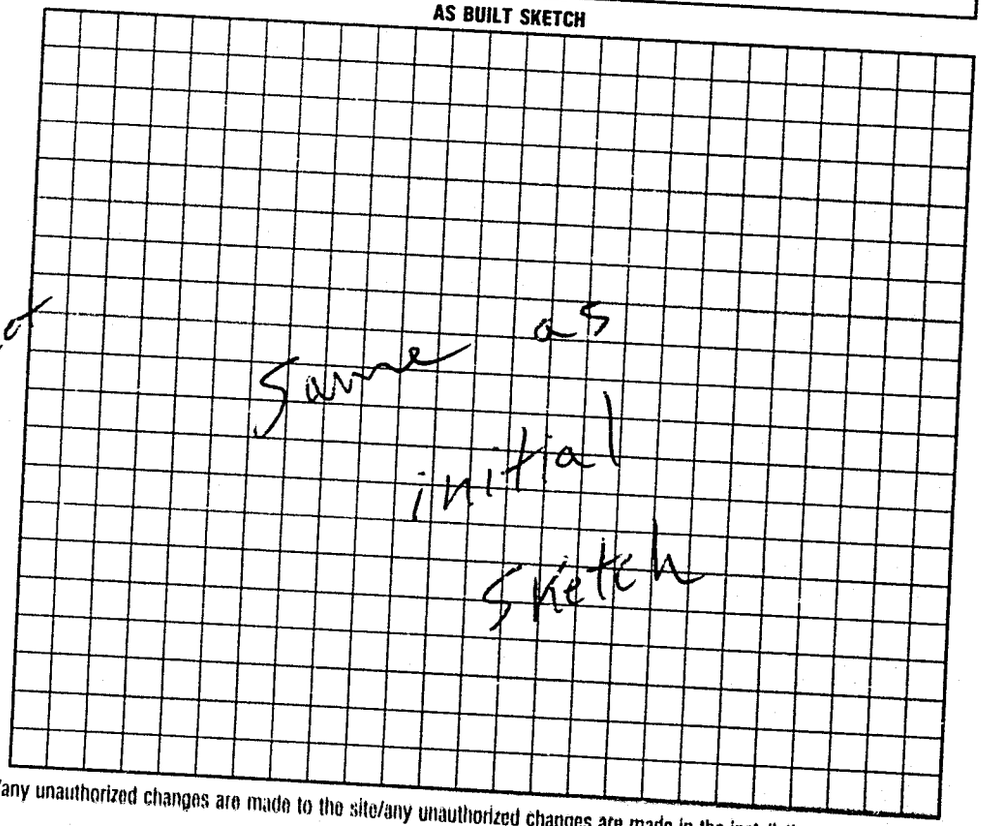

I understand that this permit can be suspended or revoked if any false information is supplied toward securing the permit/any unauthorized changes are made to the site/any unauthorized changes are made in the installation of the system. Improvement Permit is valid for 60 months from date of issuance.

Signed: X Jeff Brinager

Improvement Permit by: J.C. Moore date 3-14-94

Existing System Inspection by: date

Installed by: J.C. Forsyth

Certificate of Completion by: J.C. Moore date 4-18-94

Operation Permit by: date

HEALTH DEPT. COPY: WHITE INSPECTION COPY (FINAL): GREEN OWNER COPY (FINAL): YELLOW INSPECTION COPY (INITIAL): PINK OWNER COPY (INITIAL): GOLD