IREDELL COUNTY HEALTH DEPARTMENT

STATESVILLE 704-878-5305 MOORESVILLE 704-664-5281

IMPROVEMENT PERMIT / AUTHORIZATION TO CONSTRUCT / OPERATION PERMIT / EXISTING SYSTEM INSPECTION

PERMIT# 97184 PIN# 4738 63 2143 DATE 10-23-98

OWNER OR CONTRACTOR Richard walker PHONE: Business _____ Home 8789624

ADDRESS 129 Beaverbrook

LOCATION 64E To Cecil Sp Rd TR Hoggshead TR Durant Hami Rd

SUBDIVISION Campbell Est BLOCK / SECTION _____ LOT 16 LOT AREA 1.47 acres SITE CLASS PS DESIGN FLOW 360 L.T.A.R. .4

Septic Tank: 1000 Gallons; STB 620 Date 8-17-98

Pump Tank: _____ Gallons; PT _____ Date _____

Pump Make: _____ Model _____ Serial No. _____

Nitrification Field: No Fields 1 Square Feet 900 Linear Feet 300

No Lines 4 Trench Width 36" Max Trench Bottom Depth 36" Gravel Depth 12"

☒ New System ☐ Repair System Type: I, II, III, IV, V, VI

System Description: Conv Gravity

Repair System Description Gravity 25% Red

Maintenance Agreement Required: ☐ Yes ☒ No

☐ House/Mod. Home ☒ Mobile Home ☐ Business ☐ Other

No. Bedrooms 3 No. Bathrooms 2 No. Employees ____


☐ Slab ☒ Crawl Space ☐ Basement w/plumbing ☐ Basement wo/plumbing

Water Supply: ☒ Individual ☐ Public ☐ Community

Comments:/Conditions: well must be Drilled well

Comments:/Conditions:

INITIAL SITE SKETCH

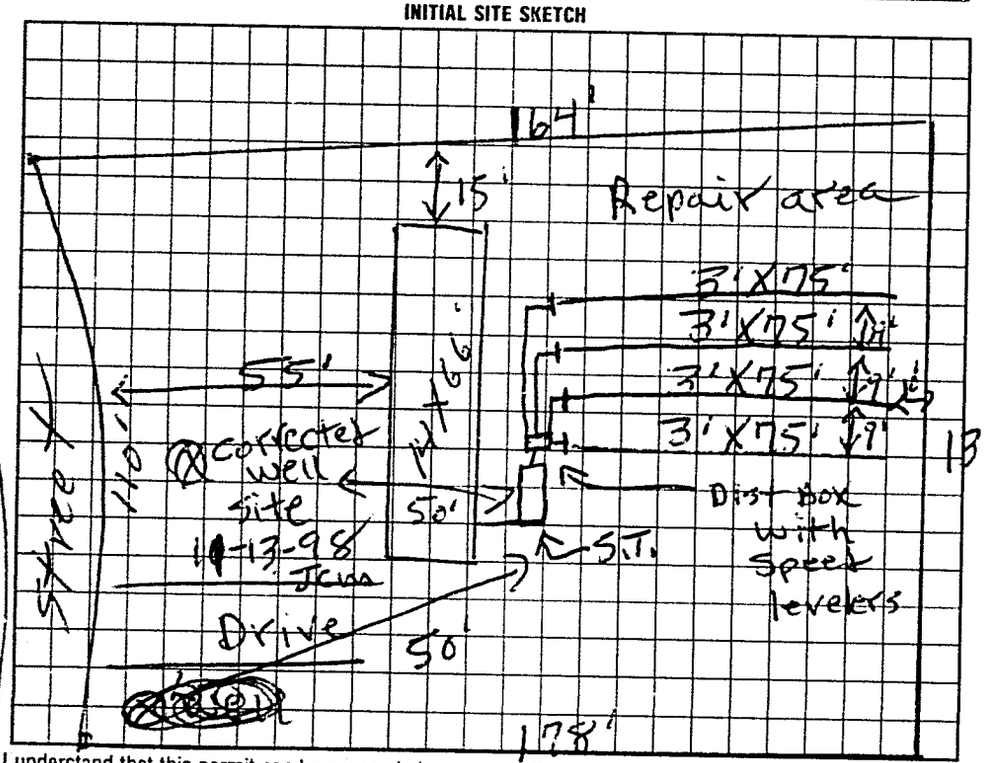

AS BUILT SKETCH

Same as initial sketch

I understand that this permit can be suspended or revoked if any false information is supplied toward securing the permit/any unauthorized changes are made to the site/any unauthorized changes are made in the installation of the system. Improvement Permit with plat valid without expiration. Improvement Permit with site plan valid for sixty months. Authorization to Construct is valid for a period equal to that of Improvement Permit – not to exceed sixty months.

Signed: Richard E Walker date 10-23-98 Installed by: Sammy Reavis

Improvement Permit by: P.C. Moore date 10-23-98 Operation Permit by: P.C. Moore date 11-13-98

Authorization to Construct by: P.C. Moore date 10-23-98 Existing System Inspection by _____ date _____

HEALTH DEPT COPY: WHITE INSPECTION COPY (FINAL): GREEN OWNER COPY (FINAL): YELLOW INSPECTION COPY (INITIAL): PINK OWNER COPY (INITIAL): GOLD

97-9000