# IREDELL COUNTY HEALTH DEPARTMENT

STATESVILLE 704-878-5305 MOORESVILLE 704-664-5281

## IMPROVEMENT PERMIT / CERTIFICATE OF COMPLETION / OPERATION PERMIT / EXISTING SYSTEM INSPECTION

[redacted] 1:00 Andy Daniels

PROPERTY DESCRIPTION NO. 21067 DATE 5-15-95 TAX MAP NO. 11K-2-A-6 Watershed: ☐ Yes ☑ No

OWNER OR CONTRACTOR Garland m. Daniels PHONE: Business _____ Home 873-0210

ADDRESS 1321 17th St Statesville

LOCATION 64 E Tl cool Sp Rd In Tasserhiat TR Durant 2nd lot left

SUBDIVISION Campbell St. BLOCK / SECTION _____ LOT 6 LOT AREA .54 Acres SITE CLASS PS DESIGN FLOW 360 L.T.A.R. .75

Septic Tank: 1000 Gallons; STB 794 Date 4/26/95

Pump Tank: _____ Gallons; PT _____ Date _____

Pump Make: _____ Model _____ Serial No. _____

Nitrification Field: No Fields 4 Square Feet 1035 Linear Feet 345

No Lines 3 Trench Width 36" Max Trench Bottom Depth 36" Gravel Depth 12"

☑ New System ☐ Repair System Type: I, II, III, IV, V, VI

System Description: Conv. Gravity

Repair System Description: Gravity Panel

Maintenance Agreement Required: ☐ Yes ☑ No

☐ House/Mod. Home No. Bedrooms 3

☑ Mobile Home No. Bathrooms 2

☐ Business No. Employees _____

☐ Other _____

☐ Slab ☑ Crawl Space ☐ Basement w/plumbing ☐ Basement wo/plumbing


Water Supply: ☐ Individual ☐ Community ☐ Public

Comments:


Comments:

Keep MH 5' minimum from tank boxes
Layout Chgd OK'd by JCM.

INITIAL SITE SKETCH

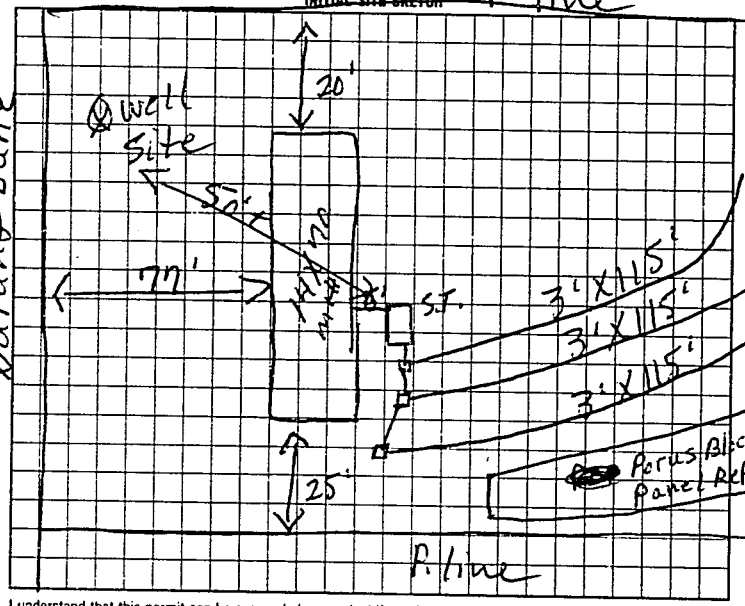


AS BUILT SKETCH

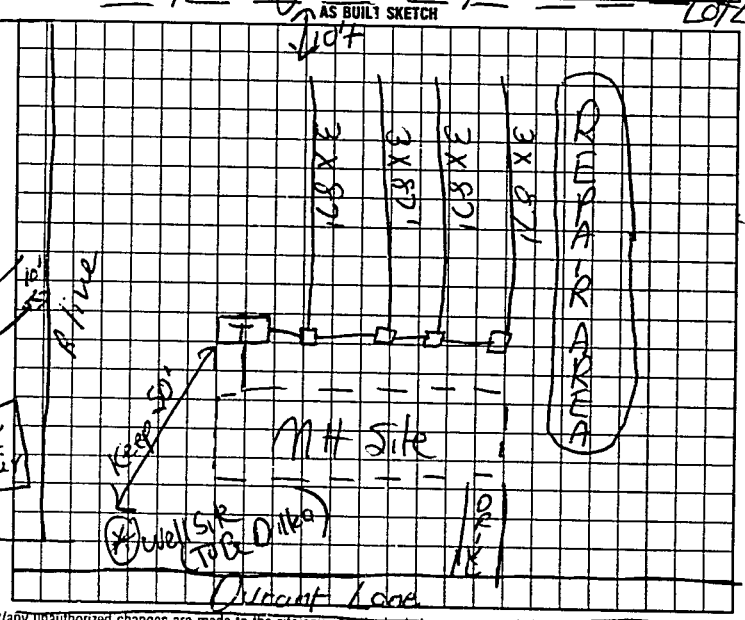


I understand that this permit can be suspended or revoked if any false information is supplied toward securing the permit/any unauthorized changes are made to the site/any unauthorized changes are made in the installation of the system. Improvement Permit is valid for 60 months from date of issuance.

Signed: X Melinda C. McDaniel

Improvement Permit by: P. C. Moore date 5-15-95

Existing System Inspection by: _____ date _____

Installed by: Andy Daniels

Certificate of Completion by: _____ date _____

Operation Permit by: _____ date 10/13/95

HEALTH DEPT. COPY: WHITE INSPECTION COPY (FINAL): GREEN OWNER COPY (FINAL): YELLOW INSPECTION COPY (INITIAL): PINK OWNER COPY (INITIAL): GOLD