IREDELL COUNTY HEALTH DEPARTMENT

STATESVILLE 704-878-5305 MOORESVILLE 704-664-5281

IMPROVEMENT PERMIT / AUTHORIZATION TO CONSTRUCT / OPERATION PERMIT / EXISTING SYSTEM INSPECTION

PERMIT# 14967 PIN# 4787633712 DATE 8-23-07

OWNER OR APPLICANT Garland Woodard

ADDRESS 115 Durand LN Statesville NC 28625 PHONE: Business _____ Home _____

LOCATION 64E (TL) Cool Springs (TR) Coggin Head RD (TR) Durand 2nd Lot on Left

SUBDIVISION Carpark Est BLOCK / SECTION _____ LOT 6 LOT AREA .59 AC SITE CLASS. B5 DESIGN FLOW 360 L.T.A.R. .35

Septic Tank: 1000 Gallons: STB 794 Date 4-26-95

Pump Tank: _____ Gallons: PT _____ Date _____

Pump Make: _____ Model _____ Serial No. _____

Nitrification Field: No Fields ___ Square Feet 1035 Linear Feet 345

No Lines 4 Trench Width 36" Max Trench Bottom Depth 36.0 Gravel Depth 12"

☐ New System ☐ Repair ☐ Expansion System Type: I II III IV V VI

System Description: Conv. Gravity (64E Sty)

Repair System Description: Panel - Repair

Maintenance Agreement Required: ☐ Yes ☐ No

☐ House/Mod. Home ☐ Mobile Home ☐ Business ☐ Other

No. Bedrooms 3 No. Persons ___ No. Employees ___


Water Supply: ☑ Individual ☐ Public ☐ Community

☑ Gravity ☐ Pressure ☐ Slab ☐ Crawl Space ☐ Basement w/plumbing ☐ Basement wo/plumbing


Comments:/Conditions:

Comments:/Conditions:

INITIAL SITE SKETCH

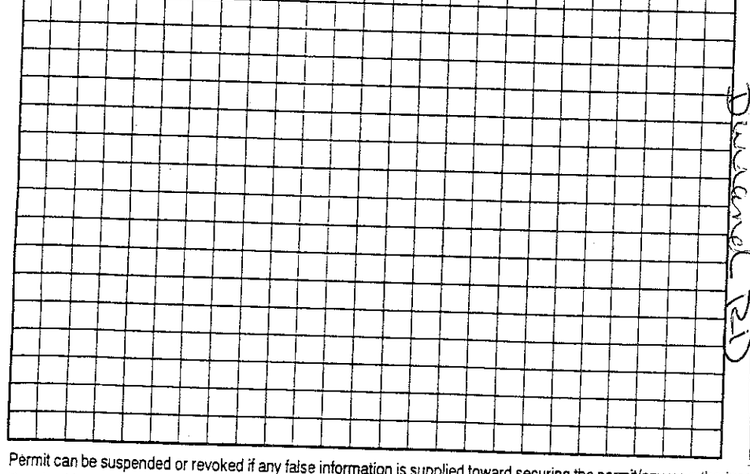

AS BUILT SKETCH

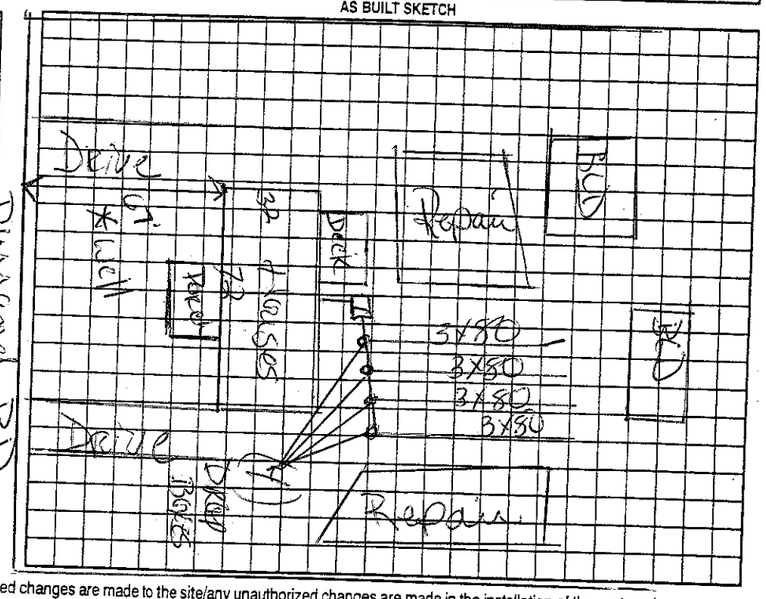

Permit can be suspended or revoked if any false information is supplied toward securing the permit/any unauthorized changes are made to the site/any unauthorized changes are made in the installation of the system. Improvement Permit with plat valid without expiration ☐ Improvement Permit with site plan valid for sixty months ☐ Authorization to Construct is valid for a period equal to that of Improvement Permit – not to exceed sixty months.

Signed: _____ date _____

Improvement Permit by: _____ date _____

Authorization to Construct by: _____ date _____

Installed by: _____

Operation Permit by: _____ date _____

Existing System Inspection by: _____ date 8-23-07

HEALTH DEPT. COPY: WHITE OWNER COPY (FINAL): YELLOW OWNER COPY (INITIAL): PINK