See attached permit #165439 for pool addition on site 7/19/11.

IREDELL COUNTY HEALTH DEPARTMENT

STATESVILLE 704-878-5305 MOORESVILLE 704-664-5281

IMPROVEMENT PERMIT / AUTHORIZATION TO CONSTRUCT / OPERATION PERMIT / EXISTING SYSTEM INSPECTION

PERMIT# 130869 PIN# 4787-80-0547 DATE 9-28-05

OWNER OR CONTRACTOR Christopher Beatty PHONE: Business Home 336-210-4667

ADDRESS 126 SHADY GROVE RD ADVANCE, NC 27006

LOCATION 64 EAST (L) COOL SPRINGS RD (R) GARDEN VALLEY 3RD DRIVE ON RT

SUBDIVISION BLOCK / SECTION LOT # LOT AREA 16.75 SITE CLASS PS DESIGN FLOW 360 L.T.A.R. .3

Septic Tank: 1000' Gallons; STB 1012 Date 2-28-06
Pump Tank: Gallons; PT Date
Pump Make: Model Serial No.
Nitrification Field: No Fields 1 Square Feet 1200' Linear Feet 400'
No Lines 3x133' Trench Width 36" Max Trench Bottom Depth 36" Gravel Depth 12"

☒ New System ☐ Repair System Type: I, (II), III, IV, V, VI
System Description: GRAV CONV
Repair System Description: 18" TB GRAV CONV
Maintenance Agreement Required: ☐ Yes ☒ No


☒ House/Mod. Home No. Bedrooms 3
☐ Mobile Home No. Bathrooms 2½
☐ Business No. Employees
☐ Other
☐ Slab ☐ Crawl Space ☒ Basement w/plumbing ☐ Basement wo/plumbing

Water Supply: ☒ Individual ☐ Public ☐ Community

Comments:/Conditions: (1) KEEP FALL TO TANK & LINES DURING BASEMENT DIGGING (2) INSTALL LINES ON CONTOURS & MAINTAIN SETBACKS (3) KEEP WELL & SYSTEM 100' APART FROM EACH OTHER. ALSO KEEP W/ 100' FROM

Comments:/Conditions: REPAIR AREA; ~~AN ALLEGED~~ [redacted] SYSTEM MAY BE USED, (4) ONLY PUTTING ON A 2 BEDROOM HOUSE, SYSTEM IS SIZED FOR AS BUILT SKETCH 3 BEDROOMS.

INITIAL SITE SKETCH

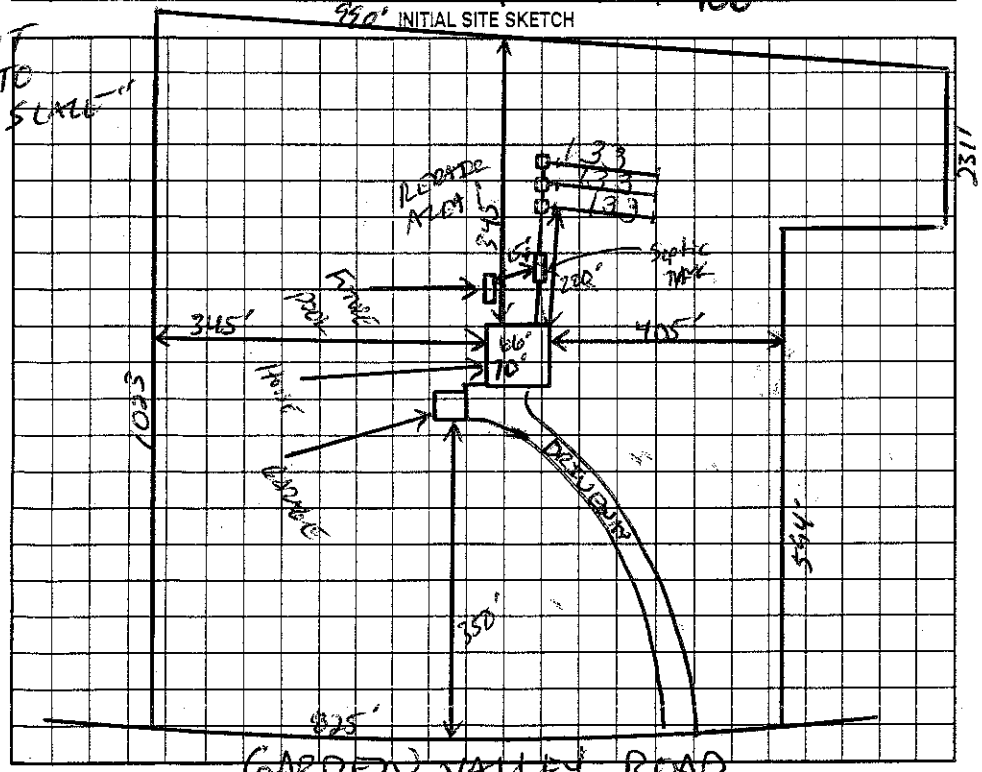

Yellow Left with Septic tank marker

3 BRM
3 with egress
1 NO window (Play Room)

Permit can be suspended or revoked if any false information is supplied toward securing the permit/any unauthorized changes are made to the site/any unauthorized changes are made in the installation of the system. Improvement Permit with plat valid without expiration. Improvement Permit with site plan valid for sixty months. Authorization to Construct is valid for a period equal to that of Improvement Permit – not to exceed sixty months.

Signed: date 9-29-05 Installed by: Steve Jordan

Improvement Permit by: date 9-28-05 Operation Permit by: date 10-16-06

Authorization to Construct by: date 9-28-05 Existing System Inspection by: date

HEALTH DEPT. COPY: WHITE OWNER COPY (FINAL): YELLOW OWNER COPY (INITIAL): PINK