IREDELL COUNTY HEALTH DEPARTMENT

STATESVILLE 704-878-5305 MOORESVILLE 704-664-5281

IMPROVEMENT PERMIT / AUTHORIZATION TO CONSTRUCT / OPERATION PERMIT / EXISTING SYSTEM INSPECTION

PERMIT# 130869 PIN# 4787-80-0597 DATE 9-28-05

OWNER OR CONTRACTOR Christopher Beatty PHONE: Business ______ Home 336-210-4667

ADDRESS 126 SHADY GROVE RD ADVANCE, NC 27006

LOCATION 64 EAST (L) COOL SPRINGS RD (R) GARDEN VALLEY 3RD DRIVE ON RT

SUBDIVISION ______ BLOCK / SECTION ______ LOT ______ LOT AREA 18.75 SITE CLASS. PS DESIGN FLOW 360 L.T.A.R. .3

Septic Tank: 1000' Gallons; STB 1012 Date 2-28-06
Pump Tank: ______ Gallons; PT ______ Date ______
Pump Make: ______ Model ______ Serial No. ______
Nitrification Field: No Fields 1 Square Feet 1200' Linear Feet 400'
No Lines 3X133' Trench Width 36" Max Trench Bottom Depth 36" Gravel Depth 12"

☒ New System ☐ Repair System Type: I, (II), III, IV, V, VI
System Description: GRAV CONV
Repair System Description: 18" TB GRAV CONV
Maintenance Agreement Required: ☐ Yes ☒ No

☒ House/Mod. Home ☐ Mobile Home ☐ Business ☐ Other ______
No. Bedrooms 3 No. Bathrooms 2½ No. Employees ______
☐ Slab ☐ Crawl Space ☒ Basement w/plumbing ☐ Basement wo/plumbing


Water Supply: ☒ Individual ☐ Public ☐ Community

Comments:/Conditions: (1) KEEP FALL TO TANK & LINES DURING BASEMENT DIGGING (2) INSTALL LINES ON CONTOURS & MAINTAIN SETBACKS (3) KEEP WELL & SYSTEM 100' APART FROM EACH OTHER. ALSO KEEP WELL 100' FROM

Comments:/Conditions: REPAIR AREA; ✗AN ALLEOTED [redacted] SYSTEM MAY BE USED. (4) ONLY PUTTING ON A 2 BEDROOM HOUSE, SYSTEM IS SIZED FOR 3 BEDROOMS.

"NOT TO SCALE"

INITIAL SITE SKETCH

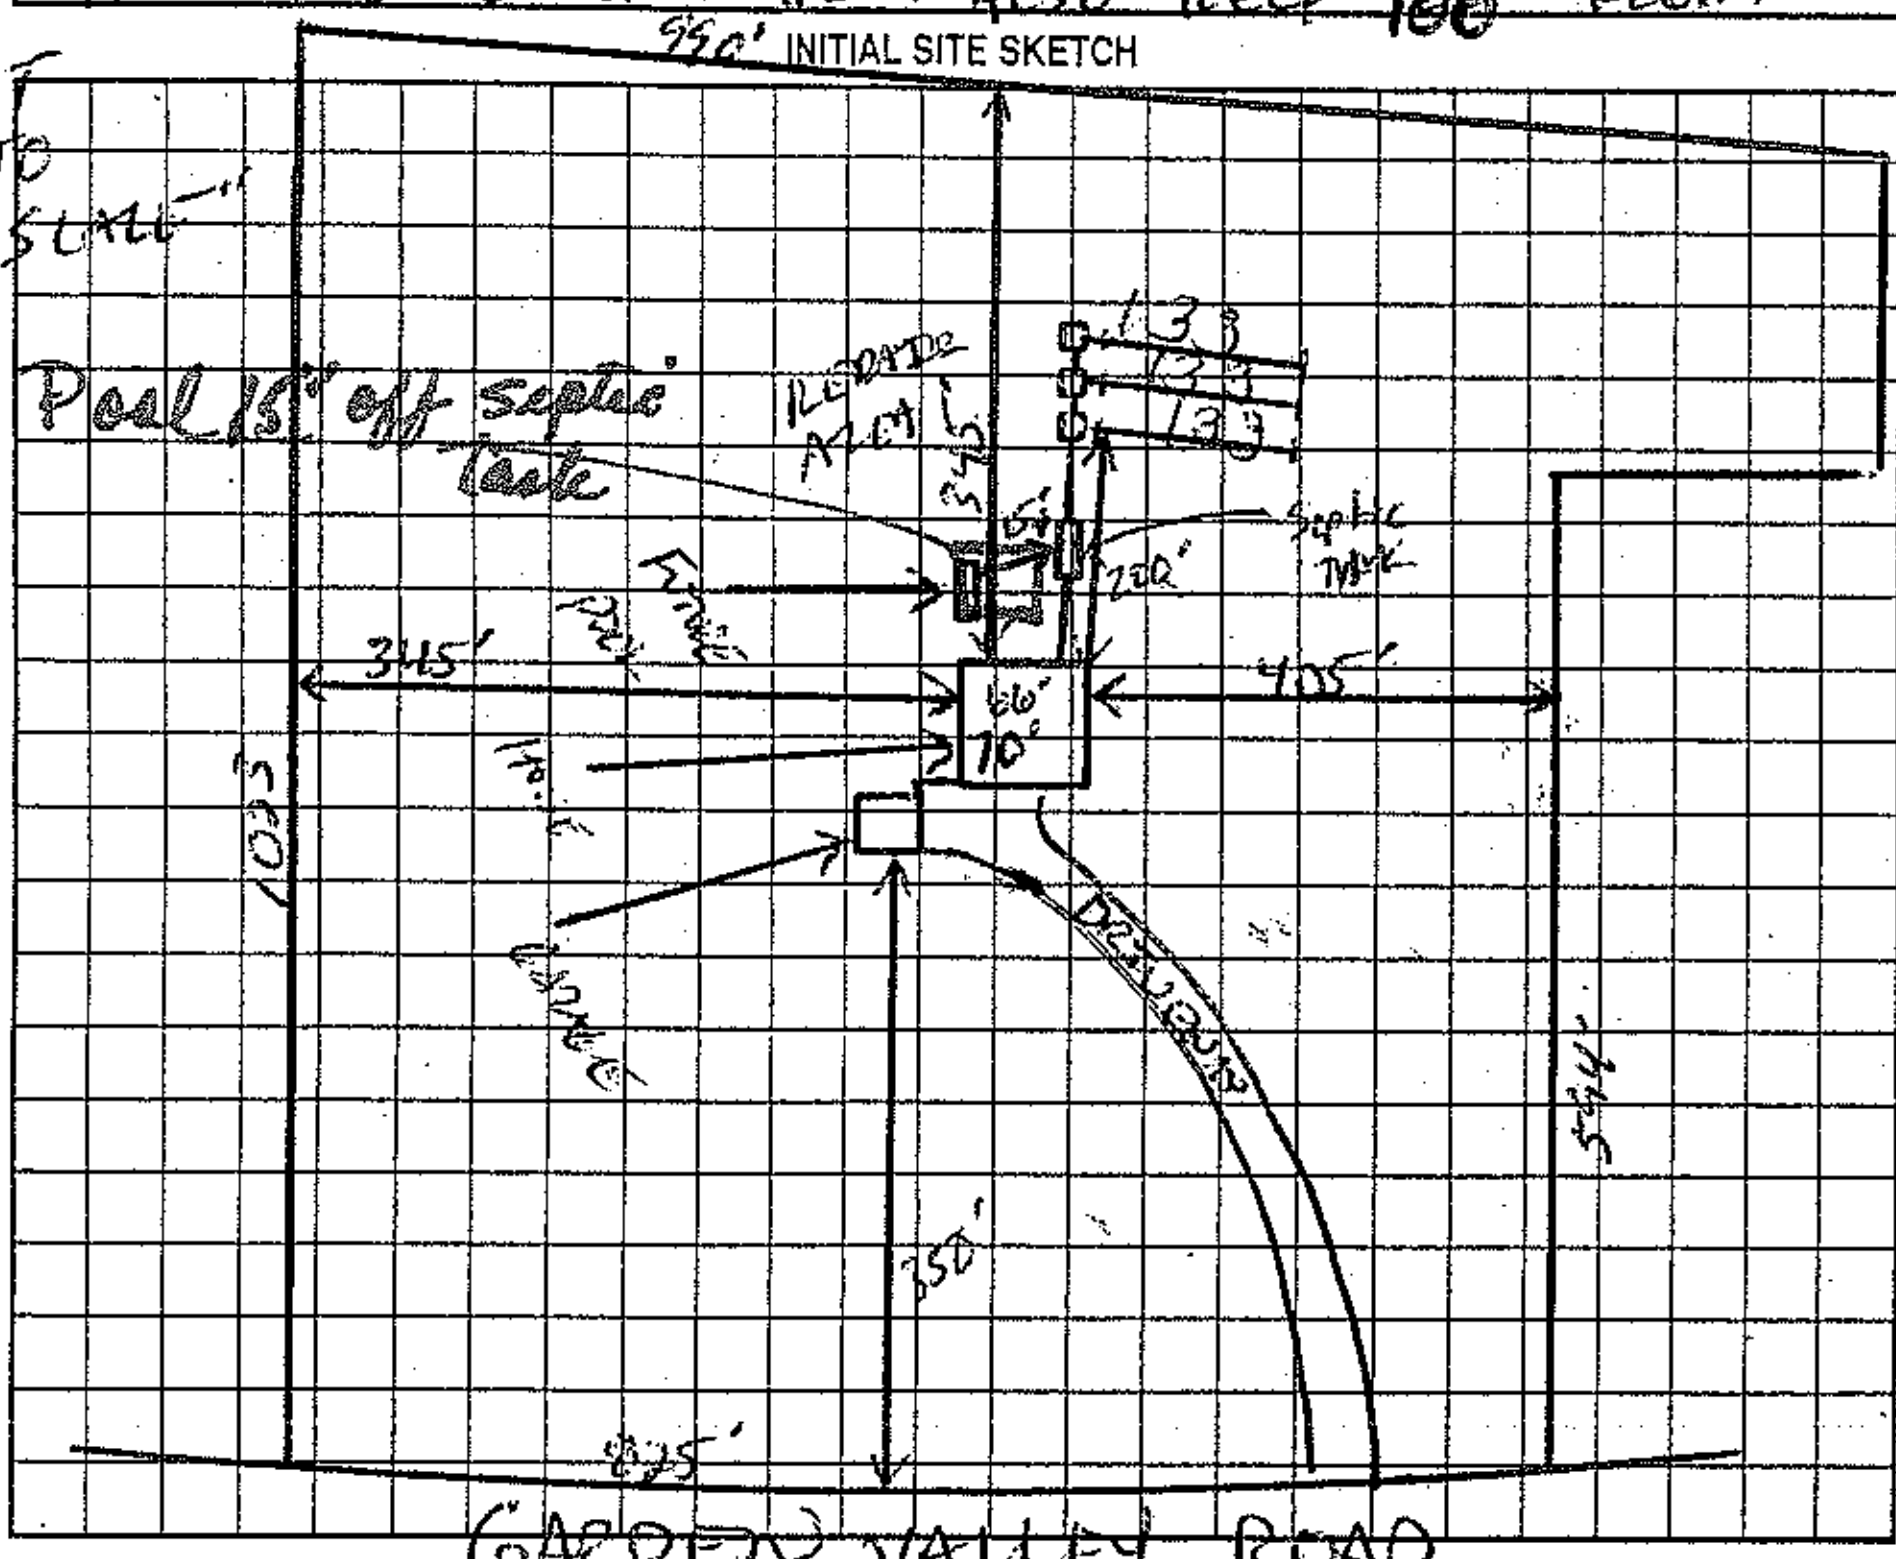

AS BUILT SKETCH

Yellow Left-hte Septic tank marker

3 BRM
3 with egress
1 no window (Play Room)

The location of the proposed pool to be built addition does not appear to impact the existing septic system.
**NOTE: Pool will be 15' off septic lines & tank per builder
______ REHS
Date: 2-9-11
ICHD-Environmental Health Division

Permit can be suspended or revoked if any false information is supplied toward securing the permit/any unauthorized changes are made to the site/any unauthorized changes are made in the installation of the system. Improvement Permit with plat valid without expiration. Improvement Permit with site plan valid for sixty months. Authorization to Construct is valid for a period equal to that of Improvement Permit – not to exceed sixty months.

Signed: ______ date 9-29-05 Installed by: Steve Jordan
Improvement Permit by: ______ date 9-28-05 Operation Permit by: ______ date 10-16-06
Authorization to Construct by: ______ date 9-28-05 Existing System Inspection by: ______ date ______

HEALTH DEPT. COPY: WHITE OWNER COPY (FINAL): YELLOW OWNER COPY (INITIAL): PINK