IREDELL COUNTY HEALTH DEPARTMENT

STATESVILLE 704-878-5305 MOORESVILLE 704-664-5281

IMPROVEMENT PERMIT / AUTHORIZATION TO CONSTRUCT / OPERATION PERMIT / EXISTING SYSTEM INSPECTION

PERMIT# 14154 PIN# 4787843200 DATE 3-6-07

OWNER OR APPLICANT Gerald Bennett PHONE: Business 704-630-6400 Home 704-883-9377

ADDRESS 328 Loggerhead RD Statesville NC 28677

LOCATION 64E (R) Cool Springs (L) garden Valley (R) Loggerhead RD 328 Loggerhead

SUBDIVISION _____ BLOCK / SECTION _____ LOT _____ LOT AREA 5 AC SITE CLASS. R3 DESIGN FLOW 240 L.T.A.R. _____

Septic Tank: 1000 Gallons; STB _____ Date _____

Pump Tank: _____ Gallons; PT _____ Date _____

Pump Make: _____ Model _____ Serial No. _____

Nitrification Field: No Fields ____ Square Feet _____ Linear Feet 240

No Lines 2 Trench Width 36" Max Trench Bottom Depth 36" Gravel Depth 12

☐ New System ☐ Repair ☐ Expansion System Type: I (II) III IV V VI

System Description: Existing

Repair System Description: Pump

Maintenance Agreement Required: ☐ Yes ☐ No

☐ Gravity ☐ Pressure

☐ House/Mod. Home No. Bedrooms 2

☐ Mobile Home No. Persons ____

☐ Business No. Employees ____

☐ Other _____

Water Supply: ☑ Individual ☐ Public ☐ Community


☐ Slab ☐ Crawl Space ☐ Basement w/plumbing ☐ Basement wo/plumbing

Comments:/Conditions:

Comments:/Conditions:

INITIAL SITE SKETCH

AS BUILT SKETCH

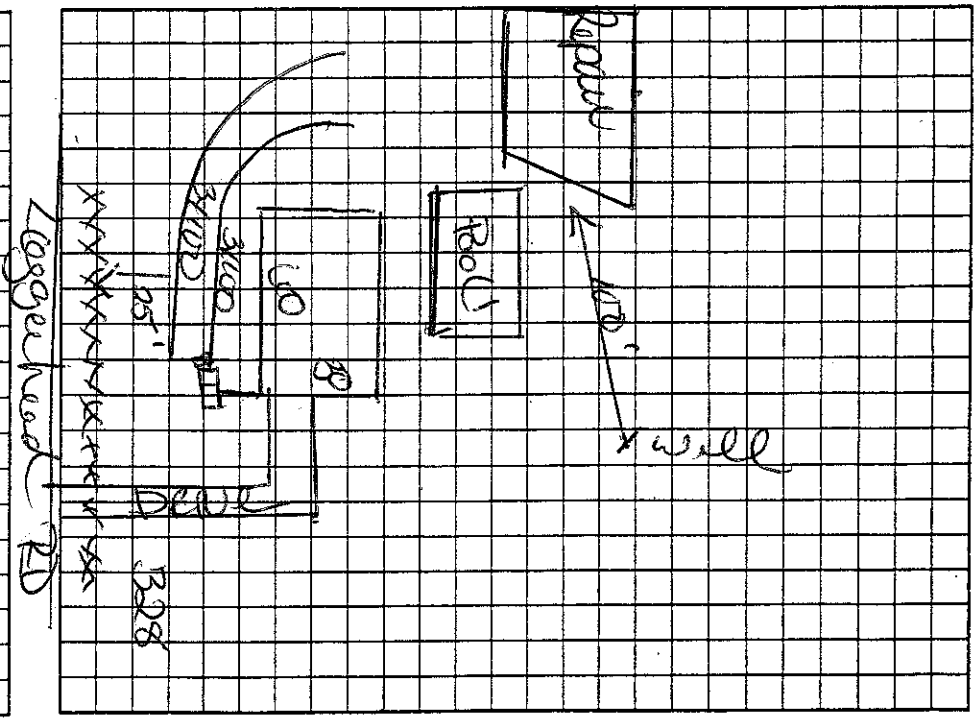

Permit can be suspended or revoked if any false information is supplied toward securing the permit/any unauthorized changes are made to the site/any unauthorized changes are made in the installation of the system. Improvement Permit with plat valid without expiration ☐ Improvement Permit with site plan valid for sixty months ☐ Authorization to Construct is valid for a period equal to that of Improvement Permit – not to exceed sixty months.

Signed: Julia Carter date 3/15/07

Improvement Permit by: _____ date _____

Authorization to Construct by: _____ date _____

Installed by: _____

Operation Permit by: _____ date _____

Existing System Inspection by: Keely Cook date 3-6-07

HEALTH DEPT. COPY: WHITE OWNER COPY (FINAL): YELLOW OWNER COPY (INITIAL): PINK