IREDELL COUNTY HEALTH DEPARTMENT

STATESVILLE 704-878-5305 MOORESVILLE 704-664-5281

IMPROVEMENT PERMIT / CERTIFICATE OF COMPLETION / OPERATION PERMIT / EXISTING SYSTEM INSPECTION

PROPERTY DESCRIPTION NO. 16490 DATE 6-15-93 TAX MAP NO. 11 H-A-10

OWNER OR CONTRACTOR Francois Barriere PHONE: Business Home 873-4966

ADDRESS Rt 1 Box 95 Statesville, N.C. 28677

LOCATION 64E TL Coolspring Rd TR Wejser Heat Rt 1½mi on rt

SUBDIVISION Cool Spring mHP BLOCK / SECTION LOT 12 LOT AREA 33250 sq' SITE CLASS. PS L.T.A.R. .4

Water Supply: ☐ Individual ☑ Community ☐ Public

Septic Tank: 1000 Gallons; STB 354 Date 4-29-93

Pump Tank: Gallons; PT Date

Nitrification Field: No Fields 1 Square Feet 900 Linear Feet 300

No Lines 3 Trench Width 36" Trench Depth 24" Gravel Depth 12"

☑ New System ☐ Repair System Type: I (II, III, IV, V, VI)

System Description: Conv. Gravity

Repair System Description:

Maintenance Agreement Required: ☐ Yes ☑ No

☐ House/Mod. Home ☑ Mobile Home ☐ Business ☐ Other

No. Bedrooms 3 No. Bathrooms 2 No. Employees

Garbage Disposal: ☐ Yes ☑ No

Auto. Dishwasher: ☑ Yes ☐ No


Auto. Washing Machine: ☑ Yes ☐ No

Other


☐ Slab ☑ Crawl Space ☐ Basement w/plumbing ☐ Basement wo/plumbing

Comments mobile Home not set at time of inspection

INITIAL SITE SKETCH

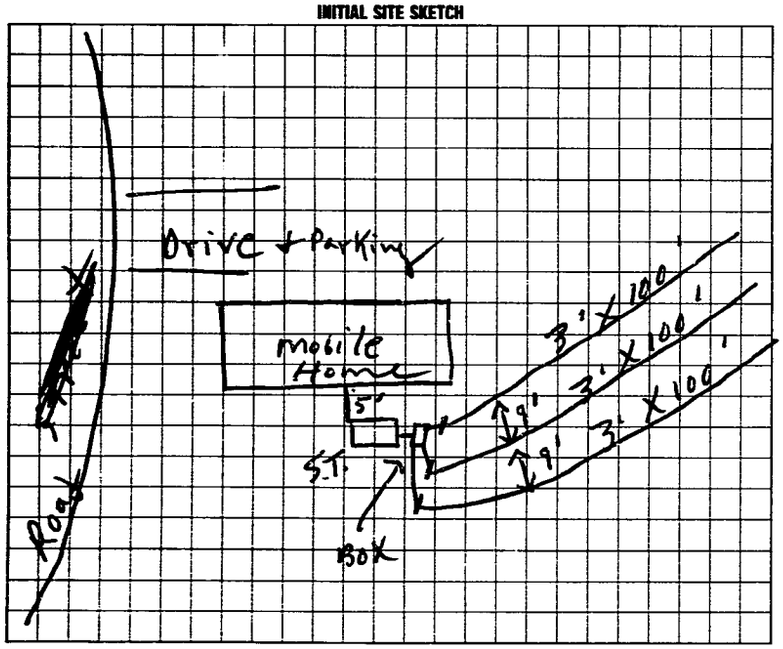

AS BUILT SKETCH

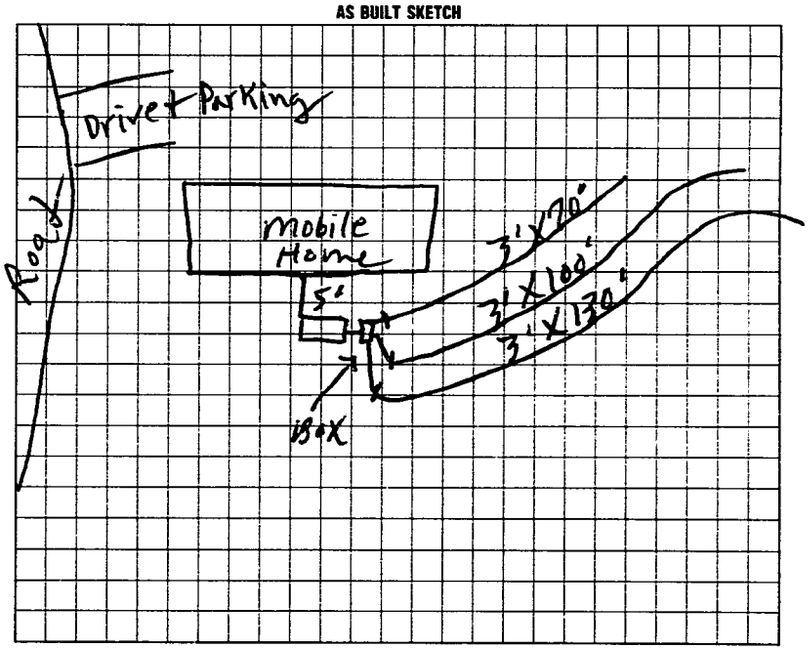

I understand that this permit can be suspended or revoked if any false information is supplied toward securing the permit/any unauthorized changes are made to the site/any unauthorized changes are made in the installation of the system. Improvement Permit is valid for 60 months from date of issuance.

Signed: Francois Barriere

Improvement Permit by: F. C. Moore date 6-15-93

Existing System Inspection by: date

Installed by: A-1 Backhoe

Certificate of Completion by: F. C. Moore date 6-16-93

Operation Permit by: date

HEALTH DEPT. COPY: WHITE INSPECTION COPY (FINAL): GREEN OWNER COPY (FINAL): YELLOW INSPECTION COPY (INITIAL): PINK OWNER COPY (INITIAL): GOLD