IREDELL COUNTY HEALTH DEPARTMENT

STATESVILLE 704-878-5305 MOORESVILLE 704-664-5281

IMPROVEMENT PERMIT / CERTIFICATE OF COMPLETION / OPERATION PERMIT / EXISTING SYSTEM INSPECTION

PROPERTY DESCRIPTION NO. 17213 DATE 10-25-93 TAX MAP NO. 11K-A-10

OWNER OR CONTRACTOR Francois Barriere PHONE: Business Watershed: ☐ Yes ☑ No

ADDRESS R+4 Box 175-14 Statesville Home 873-4966

LOCATION I-40 E TL Coolsp. Rd TR Gaston Valley TL Logger Heat 2nd Dr. TR

SUBDIVISION Coolspring mtn BLOCK / SECTION LOT 13 LOT AREA 30,000 SF SITE CLASS PS DESIGN FLOW 360 L.T.A.R. .4

Septic Tank: 1000 Gallons; STB 782 Date 9-16-93

Pump Tank: Gallons; PT Date

Pump Make: Model Serial No.

Nitrification Field: No Fields 1 Square Feet 900 Linear Feet 300

No Lines 3 Trench Width 24 Max Trench Bottom Depth 24 to 36 Gravel Depth 12

☑ New System ☐ Repair System Type: I, ☑ II, III, IV, V, VI

System Description: Conv. Gravity

Repair System Description: Peruss Block Panel

Maintenance Agreement Required: ☐ Yes ☐ No

☐ House/Mod. Home No. Bedrooms 3

☐ Mobile Home No. Bathrooms 2

☐ Business No. Employees


☐ Other

☐ Slab ☑ Crawl Space ☐ Basement w/plumbing ☐ Basement wo/plumbing

Water Supply: ☐ Individual ☑ Community ☐ Public


Comments: long lines Run 1' out contour Start 36" Run to 24" deep

INITIAL SITE SKETCH

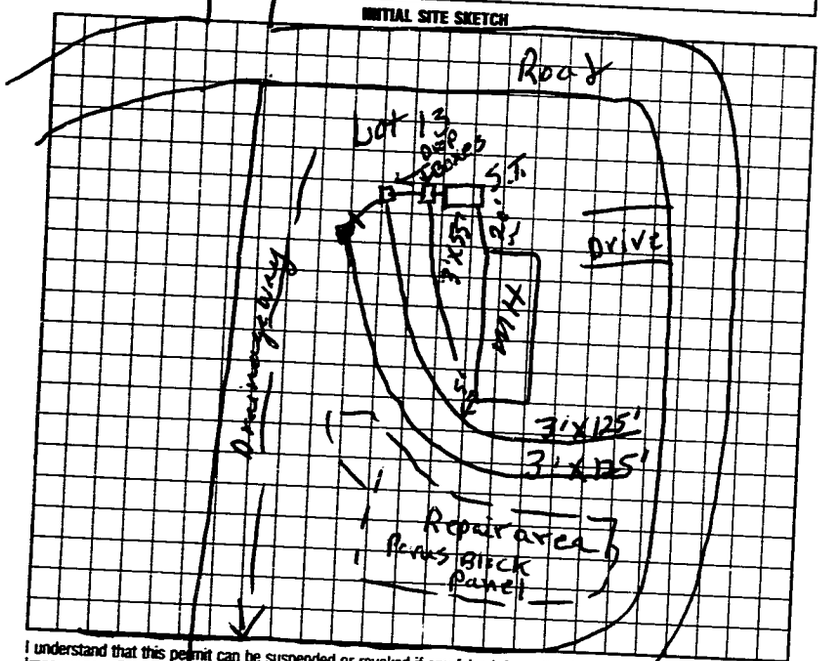

Comments:

AS BUILT SKETCH

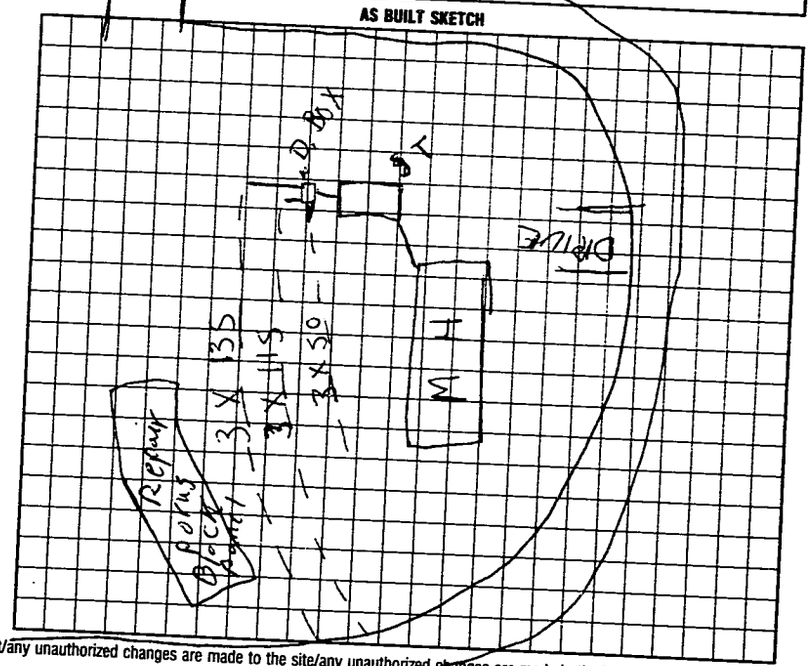

I understand that this permit can be suspended or revoked if any false information is supplied toward securing the permit/any unauthorized changes are made to the site/any unauthorized changes are made in the installation of the system. Improvement Permit is valid for 60 months from date of issuance.

Signed: x Francis Barriere

Improvement Permit by: R. C. Moore date 10-25-93

Existing System Inspection by: date

Installed by: A-1 Backhoe

Certificate of Completion by: R. C. Moore date 10-29-93

Operation Permit by: date

HEALTH DEPT. COPY: WHITE INSPECTION COPY (FINAL): GREEN OWNER COPY (FINAL): YELLOW INSPECTION COPY (INITIAL): PINK OWNER COPY (INITIAL): GOLD