57821

# IREDELL COUNTY HEALTH DEPARTMENT

STATESVILLE 704-878-5305 MOORESVILLE 704-664-5281

## IMPROVEMENT PERMIT / CERTIFICATE OF COMPLETION / OPERATION PERMIT / EXISTING SYSTEM INSPECTION

PROPERTY DESCRIPTION NO. 22140 DATE 10-5-95 TAX MAP NO. 11K-A-10 Watershed: ☐ Yes ☒ No

OWNER OR CONTRACTOR Donna Hupp PHONE: Business Home 877-1639

ADDRESS 209 maple leaf Dr. Statesville

LOCATION 64E TL Cool Sp. Rd TR Garden Valley TL Log Cabin MHP Rt

SUBDIVISION Cool Sp MHP BLOCK / SECTION LOT 9 LOT AREA SITE CLASS DESIGN FLOW L.T.A.R.

Septic Tank: Gallons; STB Date

Pump Tank: Gallons; PT Date

Pump Make: Model Serial No.

Nitrification Field: No Fields Square Feet Linear Feet

No Lines Trench Width Max Trench Bottom Depth Gravel Depth

☐ New System ☐ Repair System Type: I, II, III, IV, V, VI

System Description:

Repair System Description:

Maintenance Agreement Required: ☐ Yes ☐ No

☐ House/Mod. Home No. Bedrooms

☐ Mobile Home No. Bathrooms

☐ Business No. Employees

☐ Other

☐ Slab ☐ Crawl Space ☐ Basement w/plumbing ☐ Basement wo/plumbing


Water Supply:
☐ Individual
☒ Community
☐ Public

Comments:

Comments:

**INITIAL SITE SKETCH**

**AS BUILT SKETCH**

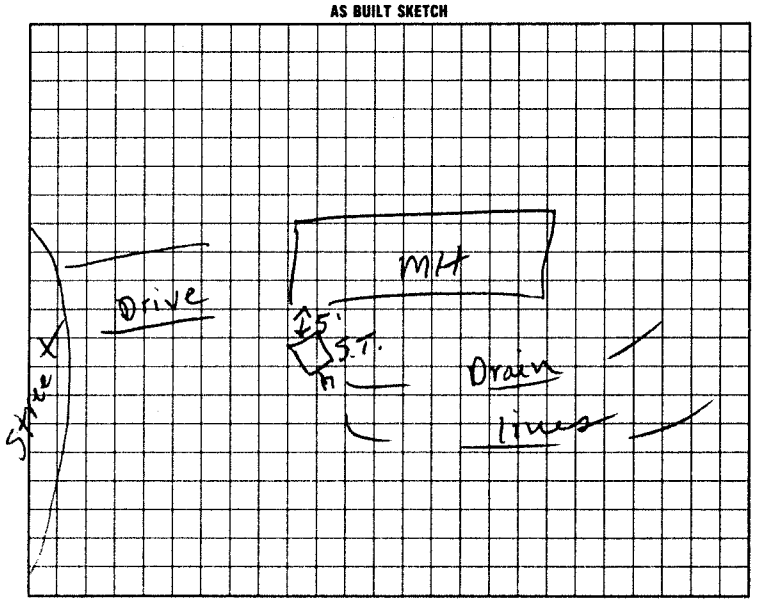


I understand that this permit can be suspended or revoked if any false information is supplied toward securing the permit/any unauthorized changes are made to the site/any unauthorized changes are made in the installation of the system.

Signed:

Improvement Permit by: date

Existing System Inspection by: L. C. Moore date 10-5-95

Installed by:

Certificate of Completion by: date

Operation Permit by: date

HEALTH DEPT. COPY: WHITE INSPECTION COPY (FINAL): GREEN OWNER COPY (FINAL): YELLOW INSPECTION COPY (INITIAL) PINK OWNER COPY (INITIAL): GOLD